

STATE ENGINEER  
Salem, Oregon

# Well Record


*Bent*  
*2393*  
STATE WELL NO. 11/3W-6E  
COUNTY BENTON  
APPLICATION NO. GR-2759

OWNER: John H. Belden MAILING ADDRESS: 810 Belden Lane

LOCATION OF WELL: Owner's No. #1 CITY AND STATE: Albany, Oregon

SW 1/4 NW 1/4 Sec. 6 T. 11 <sup>N.</sup>S, R. 3 <sup>E.</sup>W., W.M.

Bearing and distance from section or subdivision corner 1110' N. and 700' E.

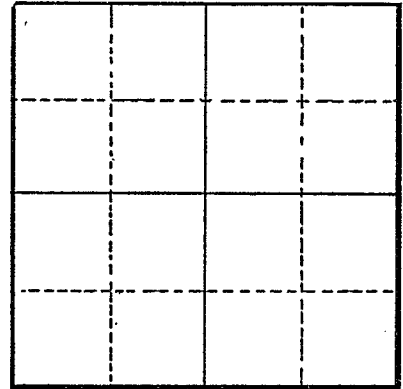

Section .....

Altitude at well .....

TYPE OF WELL: drilled Date Constructed 1944

Depth drilled 52 Depth cased 42

CASING RECORD:

6-inch

FINISH:

Cut slots from 35 to 38

AQUIFERS:

WATER LEVEL:

30-feet

PUMPING EQUIPMENT: Type Jacuzzi Jet H.P. 1

Capacity 1800 gphr. ~~G.P.M.~~

WELL TESTS:

Drawdown ..... ft. after ..... hours Pumping 2000 per hour. ~~G.P.M.~~

Drawdown ..... ft. after ..... hours ..... G.P.M.

USE OF WATER irrigation Temp. ..... °F. ...., 19

SOURCE OF INFORMATION GR-2607

DRILLER or DIGGER Mr. West, Salem, Oregon

ADDITIONAL DATA:

Log ..... Water Level Measurements ..... Chemical Analysis ..... Aquifer Test .....

REMARKS: