

STATE ENGINEER
Salem, Oregon

Well Record

Bent
2394

STATE WELL NO. 11/3W-6E
COUNTY Benton
APPLICATION NO. GR-2525

OWNER: Chas. K. McCormack, Secretary,
Cloverdale Farms, Inc.

MAILING ADDRESS: P. O. Box 392,


LOCATION OF WELL: Owner's No. #1

CITY AND STATE: Albany, Oregon

SW 1/4 NW 1/4 Sec. 6 T. 11 S. R. 3 W., W.M.

Bearing and distance from section or subdivision

corner 1650' W. and 250' N.

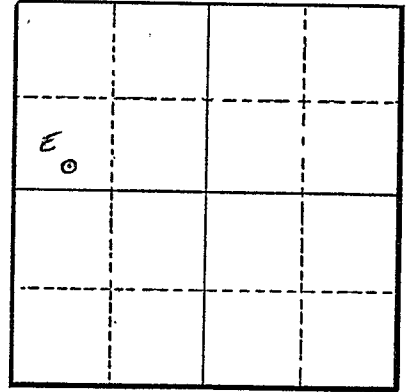

Section 6

Altitude at well

TYPE OF WELL: Dug Date Constructed 1929

Depth drilled 30 Depth cased 30

CASING RECORD:

10-inch

FINISH:

AQUIFERS:

WATER LEVEL:

18-feet

PUMPING EQUIPMENT: Type Centrifugal H.P. 10
Capacity 220 G.P.M.

WELL TESTS:

Drawdown 2 ft. after _____ hours Pumping 200 G.P.M.

Drawdown _____ ft. after _____ hours _____ G.P.M.

USE OF WATER Irrigation Temp. _____ °F. _____, 19____

SOURCE OF INFORMATION GR-2405

DRILLER or DIGGER Unknown - Hamilton name of driller unknown, but perhaps is Bill Hamilton.

ADDITIONAL DATA:

Log _____ Water Level Measurements _____ Chemical Analysis _____ Aquifer Test _____

REMARKS: