

STATE ENGINEER  
Salem, Oregon

# Well Record

*Bent*  
*2395*

STATE WELL NO. 11/3W-6E  
COUNTY ~~HENN~~ Benton  
APPLICATION NO. GB-2542

OWNER: Chas K. McCormack & Harold E. Hansen


MAILING ADDRESS: P. O. Box 392

LOCATION OF WELL: Owner's No.

CITY AND STATE: Albany, Oregon

SW 1/4 NW 1/4 Sec. 6 T. 11 ~~N~~ S, R. 3 ~~E~~ W., W.M.

Bearing and distance from section or subdivision corner 1584' W. 792' N.

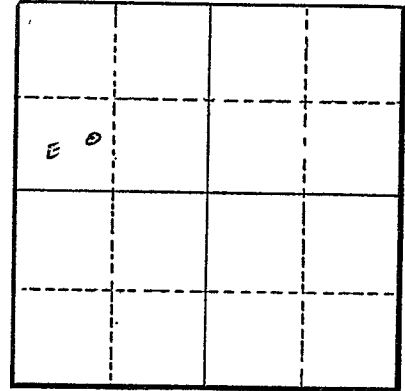

Section 6

Altitude at well

TYPE OF WELL: Drilled Date Constructed 1953

Depth drilled 28 Depth cased 28

### CASING RECORD:

6-inch

### FINISH:

### AQUIFERS:

### WATER LEVEL:

18-feet

PUMPING EQUIPMENT: Type Centrifugal H.P. 5  
Capacity 350 G.P.M.

### WELL TESTS:

Drawdown 2 ft. after hours Pumping 800 G.P.M.  
Drawdown ft. after hours G.P.M.

USE OF WATER Irrigation Temp. °F., 19

SOURCE OF INFORMATION GR-2402

DRILLER or DIGGER Bill Hamilton, Albany, Oregon

### ADDITIONAL DATA:

Log Water Level Measurements Chemical Analysis Aquifer Test

### REMARKS: