

STATE ENGINEER
Salem, Oregon

Well Record

Bent
296

STATE WELL NO. 11/3W-6F
COUNTY Benton
APPLICATION NO. GR-3002

OWNER: Arvid T. or Lulu A. Olson


MAILING ADDRESS: 526 West 11th Avenue

LOCATION OF WELL: Owner's No. _____

CITY AND STATE: Albany, Oregon

SE 1/4 NW 1/4 Sec. 6 T. 11 N. S., R. 3 E. W., W.M.

Bearing and distance from section or subdivision corner 1452' S. and 2376' E.

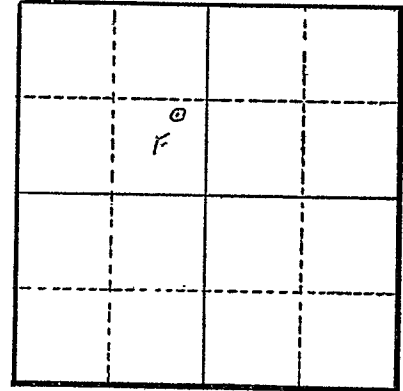

Section 6

Altitude at well _____

TYPE OF WELL: drilled Date Constructed 1947

Depth drilled 91 Depth cased 87

CASING RECORD:

6-inch

FINISH:

Slot perforations from 79 to 87

AQUIFERS:

WATER LEVEL:

20-feet

PUMPING EQUIPMENT: Type Fairbanks Morse Centrifugal
Capacity 35 G.P.M.

H.P. 1 1/2

WELL TESTS:

Drawdown _____ ft. after _____ hours _____ G.P.M.

Drawdown _____ ft. after _____ hours _____ G.P.M.

USE OF WATER Irrigation Temp. _____ °F. _____, 19____

SOURCE OF INFORMATION GR-2811

DRILLER or DIGGER Nicholas Klaus, Rt. 4, Albany, Oregon

ADDITIONAL DATA:

Log _____ Water Level Measurements _____ Chemical Analysis _____ Aquifer Test _____

REMARKS: