

STATE ENGINEER
Salem, Oregon

Well Record *Bent*
2397

STATE WELL NO. 11/3W-6M
COUNTY ~~Wagon~~ Benton
APPLICATION NO. GR-2546

OWNER: Chas K. McCormack, Secretary,
Cloverdale Farms, Inc.


MAILING ADDRESS: P. O. Box 392,
CITY AND STATE: Albany, Oregon

LOCATION OF WELL: Owner's No. #2

NW 1/4 SW 1/4 Sec. 6 T. 11 S, R. 3 W., W.M.

Bearing and distance from section or subdivision

corner 17.15' W. & 937' S.

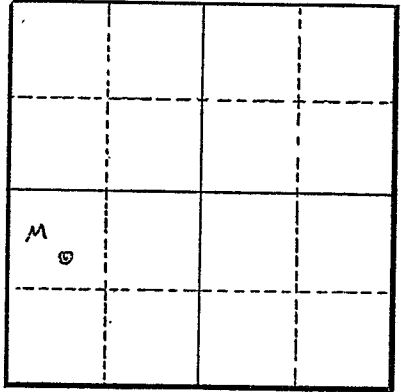

Altitude at well

TYPE OF WELL: Drilled Date Constructed 1941

Depth drilled 36 Depth cased 36

Section 6

CASING RECORD:

8-inch

FINISH:

6 per foot 3/8" x 8" from 19 to 28

AQUIFERS:

WATER LEVEL:

9-feet

PUMPING EQUIPMENT: Type Centrifugal H.P. 15
Capacity 220 G.P.M.

WELL TESTS:

Drawdown 1 ft. after hours Pumping 500 G.P.M.
Drawdown ft. after hours G.P.M.

USE OF WATER Irrigation Temp. °F. 19

SOURCE OF INFORMATION GR-2406

DRILLER or DIGGER Janssen, Newberg or Beaverton, Oregon

ADDITIONAL DATA:

Log Water Level Measurements Chemical Analysis Aquifer Test

REMARKS: