

STATE ENGINEER  
Salem, Oregon

# Well Record

*Bent*  
*23078*

STATE WELL NO. 11/3W-6M  
COUNTY Benton  
APPLICATION NO. GR-2547

OWNER: Chas K. McCormack, Secretary,  
Cloverdale Farms, Inc.

MAILING ADDRESS: P. O. Box 392


LOCATION OF WELL: Owner's No. #3

CITY AND STATE: Albany, Oregon

NW 1/4 SW 1/4 Sec. 6 T. 11 S., R. 3 W., W.M.

Bearing and distance from section or subdivision

corner 1333' W. ' 1023' S.

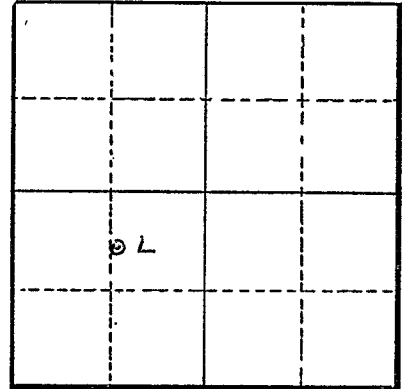

Section 6

Altitude at well .....

TYPE OF WELL: Drilled Date Constructed 1941

Depth drilled 36 Depth cased 36

### CASING RECORD:

8-inch

### FINISH:

6 per foot 3/8" x 8" from 19 to 28

### AQUIFERS:

### WATER LEVEL:

9-feet

PUMPING EQUIPMENT: Type Centrifugal H.P. 25  
Capacity 1000 G.P.M.

### WELL TESTS:

Drawdown 1 ft. after ..... hours Pumping 1000 G.P.M.

Drawdown ..... ft. after ..... hours ..... G.P.M.

USE OF WATER Irrigation Temp. ..... °F. ...., 19.....

SOURCE OF INFORMATION GR-2407

DRILLER or DIGGER Janssen - Newberg or Beaverton, Oregon

### ADDITIONAL DATA:

Log ..... Water Level Measurements ..... Chemical Analysis ..... Aquifer Test .....

### REMARKS: