

STATE ENGINEER
Salem, Oregon

Well Record

Ben
2428

STATE WELL NO. 11/4W-1G
COUNTY Benton
APPLICATION NO. GR-3802

OWNER: Floyd D. Inghram

MAILING

ADDRESS: Route 4, Box 203

LOCATION OF WELL: Owner's No. _____


CITY AND

STATE: Albany, Oregon

SW 1/4 NE 1/4 Sec. 1 T. 11 S., R. 4 W., W.M.

Bearing and distance from section or subdivision

corner 2326' S. & 1848' W. of NE Cor. of Sec. 1

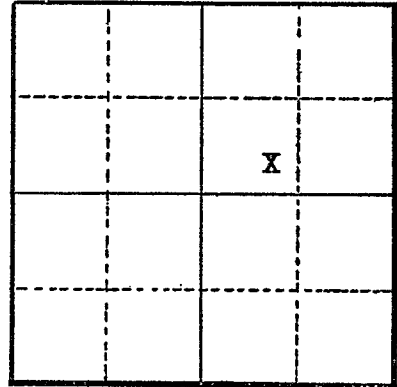

Section 1

Altitude at well _____

TYPE OF WELL: Drilled Date Constructed 1946

Depth drilled 63 feet Depth cased 63 feet

CASING RECORD:

6 inch steel casing set to 63 feet

FINISH:

Slot perforations from 43 to 63 feet

AQUIFERS:

WATER LEVEL:

PUMPING EQUIPMENT: Type 1 1/4" Jet H.P. 2
Capacity 50 G.P.M.

WELL TESTS:

Drawdown _____ ft. after _____ hours _____ G.P.M.

Drawdown _____ ft. after _____ hours _____ G.P.M.

USE OF WATER Irrigation Temp. _____ °F., 19 _____

SOURCE OF INFORMATION Well Registration Statement

DRILLER or DIGGER Nicholas Klaus

ADDITIONAL DATA:

Log _____ Water Level Measurements _____ Chemical Analysis _____ Aquifer Test _____

REMARKS:

3064