

STATE ENGINEER
Salem, Oregon

Well Record

Bent
24201

STATE WELL NO. 11/44-16
COUNTY Benton
APPLICATION NO. GR-1586

GR- 1534

OWNER: Ruby R. Muller


MAILING ADDRESS: 820 N. Albany Rd.

LOCATION OF WELL: Owner's No. _____

CITY AND STATE: Albany, Oregon

SW $\frac{1}{4}$ NE $\frac{1}{4}$ Sec. 1 T. 11 S., R. 4 W., W.M.

Bearing and distance from section or subdivision corner 1584' S. & 1420' W. from NE cor. Sec. 1

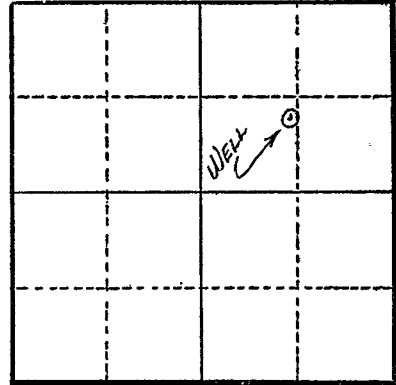

Section 1

Altitude at well 190

TYPE OF WELL: Drilled Date Constructed 1951

Depth drilled 32' Depth cased 32'

CASING RECORD:
10"

FINISH:
Slot perforations from 17 to 32 ft.

AQUIFERS:

WATER LEVEL:
16'

PUMPING EQUIPMENT: Type Pacific 1 $\frac{1}{2}$ " Cent. H.P. 1
Capacity 75 G.P.M.

WELL TESTS:
Drawdown 8 ft. after _____ hours 50 G.P.M.
Drawdown _____ ft. after _____ hours _____ G.P.M.

USE OF WATER Irrigation Temp. _____ °F., 19 _____

SOURCE OF INFORMATION GR Record

DRILLER or DIGGER Nicholas Klaus

ADDITIONAL DATA:
Log N.A. Water Level Measurements _____ Chemical Analysis _____ Aquifer Test _____

REMARKS:
Irrigation of 20.9 acres.