

STATE ENGINEER  
Salem, Oregon

# Well Record


*Bent*  
*2486* STATE WELL NO. 11/4W-2G  
COUNTY BENTON  
APPLICATION NO. GR-2874

OWNER: Walker Floral Company (Clifford W. Walker) MAILING ADDRESS: Rt. 4, Box 208 E.,

LOCATION OF WELL: Owner's No. \_\_\_\_\_ CITY AND STATE: Albany, Oregon

SW  $\frac{1}{4}$  NE  $\frac{1}{4}$  Sec. 2 T. 11 N. S, R. 4 E. W., W.M.

Bearing and distance from section or subdivision corner 2970' N. and 2376' W.

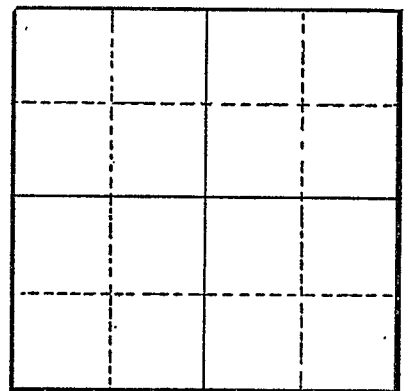

Section \_\_\_\_\_

Altitude at well \_\_\_\_\_

TYPE OF WELL: drilled Date Constructed 1951

Depth drilled 38 Depth cased 38

CASING RECORD:

6-inch

FINISH:

AQUIFERS:

WATER LEVEL:  
20-feet

PUMPING EQUIPMENT: Type Fairbanks Morse Centrifugal H.P. 3  
Capacity \_\_\_\_\_ G.P.M.

WELL TESTS:

Drawdown \_\_\_\_\_ ft. after \_\_\_\_\_ hours \_\_\_\_\_ G.P.M.  
Drawdown \_\_\_\_\_ ft. after \_\_\_\_\_ hours \_\_\_\_\_ G.P.M.

USE OF WATER irrigation Temp. \_\_\_\_\_ °F. \_\_\_\_\_, 19\_\_\_\_

SOURCE OF INFORMATION GR-2708

DRILLER or DIGGER Slate Well Drilling Co., Tangent, Oregon

ADDITIONAL DATA:

Log \_\_\_\_\_ Water Level Measurements \_\_\_\_\_ Chemical Analysis \_\_\_\_\_ Aquifer Test \_\_\_\_\_

REMARKS: