

STATE ENGINEER  
Salem, Oregon

# Well Record

STATE WELL NO. 11/4W-20  
COUNTY Benton  
APPLICATION NO. GR-1591

GR- 1539

*Cent*  
*2491*

OWNER: Fielding C. Parker


MAILING ADDRESS: Rt. 4, Box 241

LOCATION OF WELL: Owner's No. \_\_\_\_\_

CITY AND STATE: Albany, Oregon

NW  $\frac{1}{4}$  SE  $\frac{1}{4}$  Sec. 2 T. 11 S., R. 4 W., W.M.

Bearing and distance from section or subdivision  
corner Approx. 2200' S. & 1400' W. from NW cor.  
of A.M. Rainwater DIC. #39

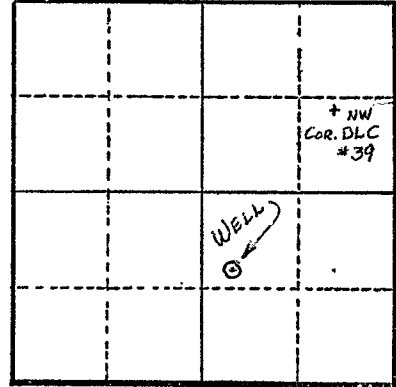

Section 2

Altitude at well About 135'

TYPE OF WELL: Driven Date Constructed 1951

Depth drilled 22' Depth cased 22'

### CASING RECORD:

2 - 1 1/4" pipes

### FINISH:

### AQUIFERS:

### WATER LEVEL:

19'

PUMPING EQUIPMENT: Type 1 1/2" Cent. H.P. 7.2  
Capacity 50 G.P.M.

### WELL TESTS:

Drawdown 0.7 ft. after \_\_\_\_\_ hours 50 G.P.M.  
Drawdown \_\_\_\_\_ ft. after \_\_\_\_\_ hours \_\_\_\_\_ G.P.M.

USE OF WATER Irrigation Temp. \_\_\_\_\_ °F., 19.

SOURCE OF INFORMATION GR Record

DRILLER or DIGGER \_\_\_\_\_

### ADDITIONAL DATA:

Log \_\_\_\_\_ Water Level Measurements \_\_\_\_\_ Chemical Analysis \_\_\_\_\_ Aquifer Test \_\_\_\_\_

### REMARKS:

Log: Sandy loam 0 to 19 ft.  
Gravel 19 to 22 ft.

Irrigation of 6 acres.