

STATE ENGINEER
Salem, Oregon

Well Record *Bent 2505* STATE WELL NO. 11/4W-4
COUNTY BENTON
APPLICATION NO. GR-2599

OWNER: Donald G. Hector

MAILING ADDRESS: Rt. 1, Box 390,

LOCATION OF WELL: Owner's No. _____

CITY AND STATE: Corvallis, Oregon

$N\frac{1}{2}$ SW $\frac{1}{4}$ SW $\frac{1}{4}$ Sec. 4 T. 11 N. 4 E. W.M.
S. R. _____


Bearing and distance from section or subdivision

corner 544' S. 63° 30' W.

Altitude at well _____

TYPE OF WELL: Drilled Date Constructed 1952

Depth drilled 57 Depth cased 57

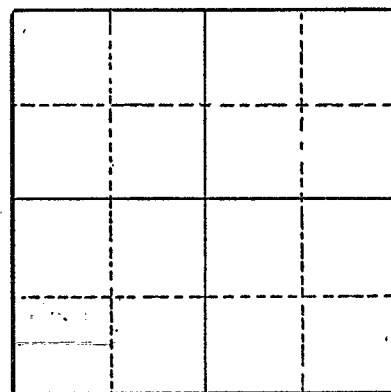

Section _____

CASING RECORD:

12-inch

FINISH:

Perforated, size and number unknown from 42 to 45
Perforated, size and number unknown from 50 to 57

AQUIFERS:

WATER LEVEL:

15-feet

PUMPING EQUIPMENT: Type F.M. Turbine H.P. 15
Capacity 230-300 G.P.M.

WELL TESTS:

Drawdown 20 ft. after _____ hours Pumping 300 G.P.M.
Drawdown _____ ft. after _____ hours _____ G.P.M.

USE OF WATER Irrigation Temp. _____ °F. _____, 19_____

SOURCE OF INFORMATION GR-2466

DRILLER or DIGGER Raymond Gellatly, Philomath, Oregon

ADDITIONAL DATA:

Log _____ Water Level Measurements _____ Chemical Analysis _____ Aquifer Test _____

REMARKS:



Oregon Water Resources Department
725 Summer Street NE, Suite A
Salem Oregon 97301
(503) 986-0900
www.oregon.gov/owrd

Application for Well ID Number

RECEIVED

JAN 14 2025

OWRD

Do not complete if the well already has a Well Identification Number.

I. OWNER INFORMATION

Current Owner Name (please print): Sterling Acres LLC
Mailing Address: PO Box 12125
City, State, Zip: Scottsdale, AZ, 85267
Mail Well ID to: ☐ SAME AS ABOVE ☒ In Care Of (C/O)
Name & Address: Daniel Hauge will pick up at OWRD office
City, State, Zip: _____

II. WELL LOCATION INFORMATION (Please fill out as completely as possible)

Township: 11 S (North / South) Range: 4 W (East / West) Section: 4 NW 1/4 of the SW 1/4
Tax Lot (usually last 3-5 numbers of Tax Map #): 500 County Benton
GPS Coordinates: 44.6402201, -123.1873790 (+/- 10-ft)
Street Address of Well, City: 204 NW Independence Hwy (W of), Albany, OR 97321
If the property had a different street address in the past: _____

III. GENERAL WELL INFORMATION (Please fill out as completely as possible, AND attach copy of Well Report, if available)

Use of Well (domestic, irrigation, commercial, industrial, monitoring): Irrigation
Date Well Constructed (or property built): 1952 Total Well Depth: 57' Casing Diameter: 12"
Owner at time the well was constructed (if known): Donald Hector Well Report # (if known): BENT 2505
Other Information: Irrigation well, authorized under GR 2599

SUBMITTED BY (please print): Agent: Michael Higgins (HGX Solutions, LLC)
PHONE: 858.775.0811 EMAIL &/or FAX: mhigginsrocks@gmail.com

To send the completed application, you may MAIL it to: Oregon Water Resources Dept. 725 Summer St NE, Suite A, Salem, Oregon 97301.
Or EMAIL the completed PDF form to: Ladeena.K.Ashley@water.oregon.gov, or FAX it to: (503) 986-0902.

For Official Use Only by the Oregon Water Resources Department:

Received Date:

1-14-2025

Well Report Number:

BENT 2505

Well Identification #:

L-157022