

STATE ENGINEER
Salem, Oregon

Well Record


Bent
295
STATE WELL NO. 11/15W-4
COUNTY BENTON
APPLICATION NO. GR-2599

OWNER: Donald G. Hector MAILING ADDRESS: Rt. 1, Box 390,

LOCATION OF WELL: Owner's No. _____ CITY AND STATE: Corvallis, Oregon

$N\frac{1}{2}$ SW $\frac{1}{4}$ SW $\frac{1}{4}$ Sec. 4 T. 11 N. S., R. 4 E. W., W.M.

Bearing and distance from section or subdivision corner 544' S. 63° 30' W.

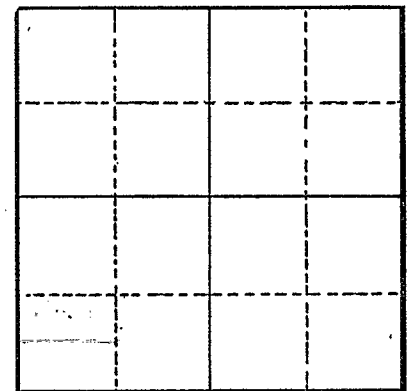

Section

Altitude at well

TYPE OF WELL: Drilled Date Constructed 1952

Depth drilled 57 Depth cased 57

CASING RECORD:

12-inch

FINISH:

Perforated, size and number unknown from 42 to 45
Perforated, size and number unknown from 50 to 57

AQUIFERS:

WATER LEVEL:

15-feet

PUMPING EQUIPMENT: Type F.M. Turbine H.P. 15
Capacity 230-300 G.P.M.

WELL TESTS:
Drawdown 20 ft. after _____ hours Pumping 300 G.P.M.
Drawdown _____ ft. after _____ hours _____ G.P.M.

USE OF WATER Irrigation Temp. _____ °F. _____, 19_____

SOURCE OF INFORMATION GR-2466

DRILLER or DIGGER Raymond Gellatly, Philomath, Oregon

ADDITIONAL DATA:
Log _____ Water Level Measurements _____ Chemical Analysis _____ Aquifer Test _____

REMARKS: