

STATE ENGINEER
Salem, Oregon

Well Record

STATE WELL NO. 11/4W-6R(1)

COUNTY Benton

APPLICATION NO. GR-673

Bent
2588
G-6194

OWNER: Alvin R. Root


MAILING ADDRESS: Rt. 1, Box 384

LOCATION OF WELL: Owner's No. 1

CITY AND STATE: Corvallis, Oregon

SE 1/4 SE 1/4 Sec. 6 T. 11 N. S., R. 4 W., W.M.

Bearing and distance from section or subdivision
corner 1060' N. & 260' W. from SE corner of section

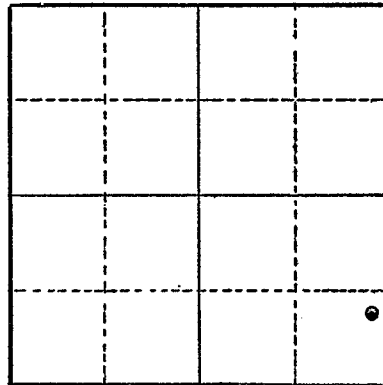

Section 6

Altitude at well 222' Interpolated

TYPE OF WELL: Drilled Date Constructed 1951

Depth drilled 42' Depth cased 38'

CASING RECORD:

10"

FINISH:

AQUIFERS:

WATER LEVEL:

11'

PUMPING EQUIPMENT: Type Jacuzzi turbine H.P. 10
Capacity 350 G.P.M.

WELL TESTS:

Drawdown 11 ft. after 260 hours G.P.M.
Drawdown ft. after hours G.P.M.

USE OF WATER Irrigation - 39.0 Ac. Temp. °F., 19

SOURCE OF INFORMATION GR-673

DRILLER or DIGGER Bill Hamilton, Albany, Oregon

ADDITIONAL DATA:

Log Water Level Measurements Chemical Analysis Aquifer Test

REMARKS: