

STATE ENGINEER
Salem, Oregon

Well Record *Bent*

STATE WELL NO. 11/4W-7B(1)
COUNTY Benton
APPLICATION NO. GR-417

2610

OWNER: E. E. Iarned


MAILING ADDRESS: Rt. 1, Box 381

LOCATION OF WELL: Owner's No. _____

CITY AND STATE: Corvallis, Oregon

NW ¼ NE ¼ Sec. 7 T. 11 S., R. 4 W., W.M.

Bearing and distance from section or subdivision
corner 864' S. & 231' E. of the projected
quarter corner between Sections 6 & 7.

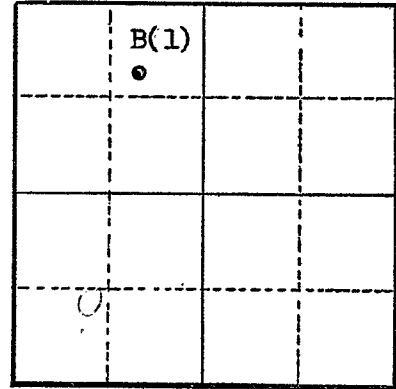

Section 7

Altitude at well 218

TYPE OF WELL: Drilled Date Constructed 3/25/53

Depth drilled 44 Depth cased 44

CASING RECORD:
10"

FINISH:

AQUIFERS:

WATER LEVEL:

28

PUMPING EQUIPMENT: Type Pamona H.P. 10
Capacity 200 G.P.M.

WELL TESTS:

Drawdown _____ ft. after _____ hours _____ G.P.M.
Drawdown _____ ft. after _____ hours _____ G.P.M.

USE OF WATER Irrigation of 35 Ac. Temp. _____ °F., 19.

SOURCE OF INFORMATION GR-417

DRILLER or DIGGER C. I. Stillings, Corvallis, Oregon

ADDITIONAL DATA:

Log No Water Level Measurements _____ Chemical Analysis _____ Aquifer Test _____

REMARKS: