

STATE ENGINEER
Salem, Oregon

Well Record

Bent
2612

STATE WELL NO. 11/4W-7R
COUNTY Benton
APPLICATION NO. GR-4110

OWNER: Elliott N. Butler

MAILING ADDRESS: Route 1


LOCATION OF WELL: Owner's No. _____

CITY AND STATE: Oregon

SE 1/4 SE 1/4 Sec. 7 T. 11 S., R. 4 W., W.M.

Bearing and distance from section or subdivision

corner 10.8 chains North and 11.0 chains West of the
Section 7.

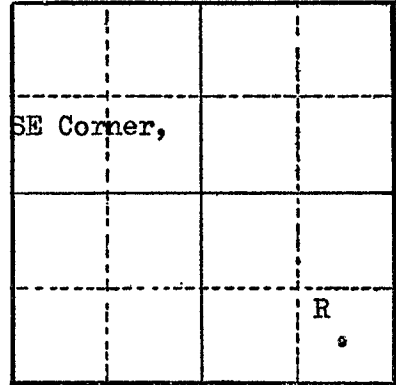

Section 7

Altitude at well 235 feet

TYPE OF WELL: Drilled Date Constructed May 25, 1952

Depth drilled 55 feet Depth cased 55 feet

CASING RECORD:

8-inch casing set from 0 to 55 feet

FINISH:

AQUIFERS:

WATER LEVEL:

35 feet

PUMPING EQUIPMENT: Type Layn Bowleer Turbin 10HP Electric H.P. 10
Capacity 250 G.P.M.

WELL TESTS:

Drawdown 52 ft. after _____ hours 150 G.P.M.

Drawdown _____ ft. after _____ hours _____ G.P.M.

USE OF WATER Irrigation Temp. _____ °F., 19 _____

SOURCE OF INFORMATION GR-4030

DRILLER or DIGGER C. A. Shaffer, Philomath, Oregon

ADDITIONAL DATA:

Log (NA) Water Level Measurements _____ Chemical Analysis _____ Aquifer Test _____

REMARKS: