



Oregon Water Resources Department
725 Summer Street NE, Suite A
Salem Oregon 97301
(503) 986-0900
www.wrd.state.or.us

Application for Well ID Number

RECEIVED

JUN 01 2016

Do not complete if the well already has a Well Identification Number.

WATER RESOURCES DEPT
SALEM, OREGON

I. OWNER INFORMATION

Current Owner Name (please print): Sandra & Donald Powell

Mailing Address: 5474 NE Highway 20

City, State, Zip: Corvallis, OR 97330

Mail Well ID Tag to: ☒ SAME AS ABOVE ☐ In Care Of (C/O)

Name & Address: L121636

City, State, Zip:

II. WELL LOCATION INFORMATION (Please fill out as completely as possible)

Township: 11S (North / South) Range: 4W (East / West) Section: 08 NW 1/4 of the SW 1/4

Tax Lot (usually last 3-5 numbers of Tax Map #): 1600 County Benton

GPS Coordinates: Latitude 44.624925088 Longitude -123.207357349

Street Address of Well, City: 5474 NE Highway 20, Corvallis, OR 97330

If the property had a different street address in the past:

III. GENERAL WELL INFORMATION (Please fill out as completely as possible, AND attach copy of Well Log, if available)

Use of Well (domestic, irrigation, commercial, industrial, monitoring): Domestic

Date Well Constructed (or property built): 1930 House Total Well Depth: Casing Diameter: Below Grade

Owner at time the well was constructed (if known): Garland Nursery/Powell Well Log # (if known):

Other Information: 1930 House, 1965 House, 1969 Mobile Home (decommissioned), 1999 Mobile Home

SUBMITTED BY (please print): Robert N. Turkisher (Benton County Environmental Health)

PHONE: 541-766-6841 EMAIL &/or FAX: 541-766-6248

Send application to: Oregon Water Resources Department 725 Summer St NE, Suite A, Salem, Oregon 97301; or fax to (503) 986-0902.
Applications are processed in the order they are received, and Well ID Numbers are mailed within 4-5 business days.

For Official Use Only by the Oregon Water Resources Department:

Received Date:

6-1-16

Well Log Number:

BENT 2616

Well Identification #:

L-121636



BENTON COUNTY ENVIRONMENTAL HEALTH ON-SITE SEWAGE DISPOSAL SYSTEM PLOT PLAN

Owner: Sandra & Donald Powell

Date: 05/25/16

SITE: -
PERMIT: 138-16-000026,27,28 - IVGN
TYPE: System Evaluation


Applicant: Same

Assessor's Map and Tax Lot Numbers: 11-4-08 TL 1600

Address: 5474 NE Highway 20, Corvallis, OR 97330

Parcel: Proposed Parcels 1, 2, & 3

Scale: 1 inch = 200 feet

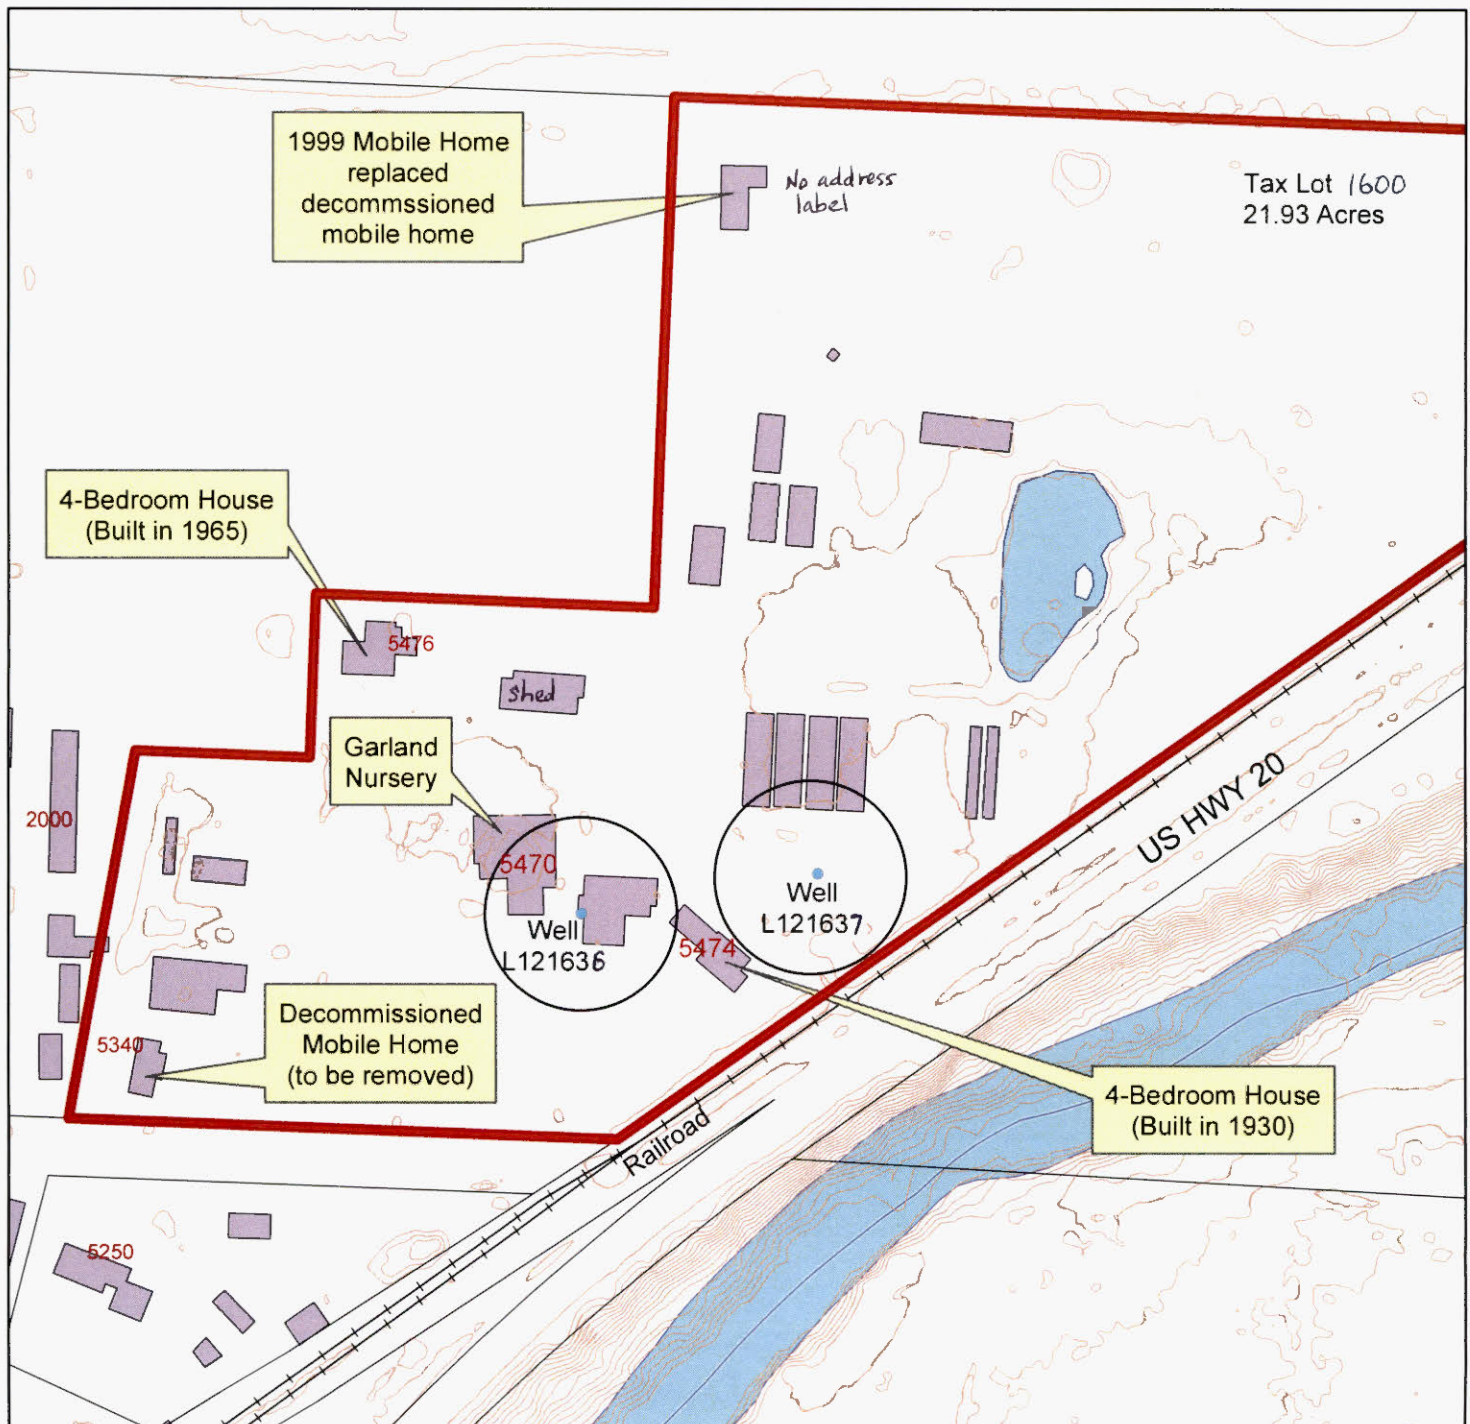

RECEIVED

JUN 01 2016

WATER RESOURCES DEPT
SALEM, OREGON

0 100 200 400
Feet



TL updated and well ID #s corrected (switched) 4-30-25