

STATE ENGINEER
Salem, Oregon

Well Record

Bent
2624

STATE WELL NO. 11/4W-8P
COUNTY Benton
APPLICATION NO. GR-4111

OWNER: Elliott N. Butler


MAILING ADDRESS: Route 1

LOCATION OF WELL: Owner's No. _____

CITY AND STATE: Corvallis, Oregon

SE $\frac{1}{4}$ SW $\frac{1}{4}$ Sec. 8 T. 11 S., R. 4 W., W.M.

Bearing and distance from section or subdivision corner 11.0 chs. N. & 5.7 chs. W. from $\frac{1}{4}$ Sec. Cor. on S. line of Sec. 8

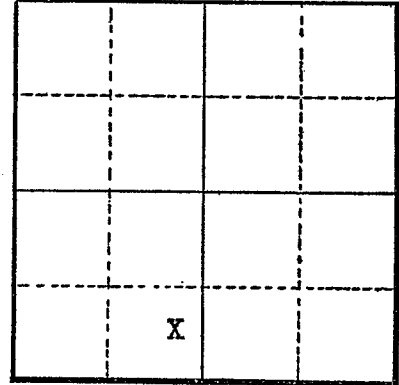

Section 8

Altitude at well _____

TYPE OF WELL: Drilled Date Constructed 5/1/52

Depth drilled 24 ft. Depth cased 20 ft.

CASING RECORD:

8 inch casing set to 20 feet

FINISH:

AQUIFERS:

WATER LEVEL:

3 feet below surface

PUMPING EQUIPMENT: Type Fairbanks Morse 3# Portable H.P. 31
Capacity 350 G.P.M.

WELL TESTS:

Drawdown 10 ft. after _____ hours 400 G.P.M.
Drawdown _____ ft. after _____ hours _____ G.P.M.

USE OF WATER Irrigation Temp. _____ °F. _____, 19

SOURCE OF INFORMATION Well Registration Statement Cert. # GR-3695

DRILLER or DIGGER C. A. Shaffer

ADDITIONAL DATA:

Log _____ Water Level Measurements _____ Chemical Analysis _____ Aquifer Test _____

REMARKS: