

STATE ENGINEER
Salem, Oregon

Well Record

STATE WELL NO. 11/4W-18Q
COUNTY BENTON
APPLICATION NO. GR-2459

2656

OWNER: Ellis & Lois Walker


MAILING ADDRESS: Rt. 1, Box 423

LOCATION OF WELL: Owner's No. _____

CITY AND STATE: Corvallis, Oregon

SW $\frac{1}{4}$ SE $\frac{1}{4}$ Sec. 18 T. 11 N. 4 R. 4 W., W.M.

Bearing and distance from section or subdivision corner 1640' W. and 760' N.

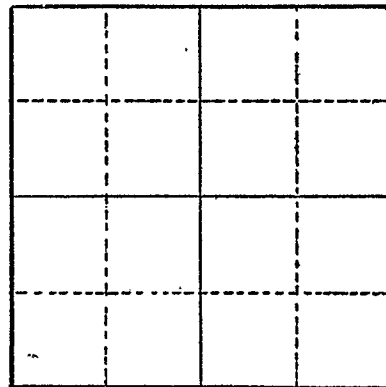

Section _____

Altitude at well _____

TYPE OF WELL: Drilled Date Constructed 1954

Depth drilled 54 Depth cased 47

CASING RECORD:

6-inch

FINISH:

Size and number unknown from 47 to 54

AQUIFERS:

WATER LEVEL:

22-feet

PUMPING EQUIPMENT: Type Fairbanks Morse Centrifugal H.P. 2
Capacity 45 G.P.M.

WELL TESTS:

Drawdown 4 ft. after _____ hours Pumping 45 G.P.M.
Drawdown _____ ft. after _____ hours _____ G.P.M.

USE OF WATER Irrigation Temp. _____ °F. _____, 19_____

SOURCE OF INFORMATION GR-2330

DRILLER or DIGGER Raymond Gellatly, Philomath, Oregon

ADDITIONAL DATA:

Log _____ Water Level Measurements _____ Chemical Analysis _____ Aquifer Test _____

REMARKS: