

STATE ENGINEER  
Salem, Oregon

# Well Record *Bent 2651*

STATE WELL NO. 11/4W-18P  
COUNTY BENTON  
APPLICATION NO. GR-2511

OWNER: A. E. Bodeker


MAILING ADDRESS: \_\_\_\_\_

LOCATION OF WELL: Owner's No. \_\_\_\_\_

CITY AND STATE: Corvallis, Oregon

SE  $\frac{1}{4}$  SW  $\frac{1}{4}$  Sec. 18 T. 11 <sup>N</sup> S., R. 4 <sup>E</sup> W., W.M.

Bearing and distance from section or subdivision corner 10.0 ch. S. 48° E. of the SW corner of the Mary Sylvester DLC #47.

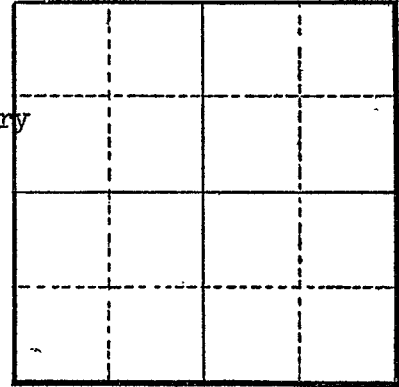

Section \_\_\_\_\_

Altitude at well \_\_\_\_\_

TYPE OF WELL: Drilled Date Constructed 1924

Depth drilled 60 Depth cased \_\_\_\_\_

CASING RECORD:

FINISH:

AQUIFERS:

WATER LEVEL:

15-feet

PUMPING EQUIPMENT: Type "Cook" H.P. 5  
Capacity 200 G.P.M.

WELL TESTS:

Drawdown \_\_\_\_\_ ft. after \_\_\_\_\_ hours \_\_\_\_\_ G.P.M.  
Drawdown \_\_\_\_\_ ft. after \_\_\_\_\_ hours \_\_\_\_\_ G.P.M.

USE OF WATER Irrigation Temp. \_\_\_\_\_ °F. \_\_\_\_\_, 19\_\_\_\_

SOURCE OF INFORMATION GR-2378

DRILLER or DIGGER Frank Skilling, Rt. 1, Corvallis, Oregon

ADDITIONAL DATA:

Log \_\_\_\_\_ Water Level Measurements \_\_\_\_\_ Chemical Analysis \_\_\_\_\_ Aquifer Test \_\_\_\_\_

REMARKS: