

STATE ENGINEER
Salem, Oregon

Well Record


STATE WELL NO. 11/4W - 18Q
COUNTY BENTON
APPLICATION NO. GR-2790

OWNER: Fern Eva Roche MAILING ADDRESS: Route 1, Box 425

LOCATION OF WELL: Owner's No. _____ CITY AND STATE: Corvallis, Oregon

SW 1/4 SE 1/4 Sec. 18 T. 11 S., R. 4 W., W.M.

Bearing and distance from section or subdivision corner 740' E. and 250' N.

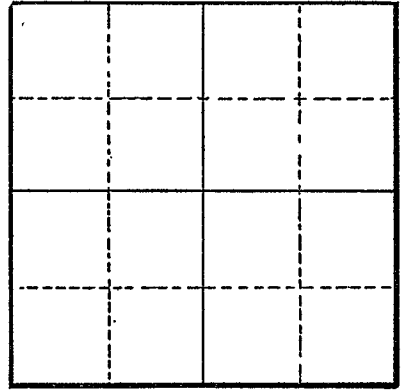

Section _____

Altitude at well _____

TYPE OF WELL: Drilled Date Constructed 1951

Depth drilled 54 Depth cased 54

CASING RECORD:

6-Inches

FINISH:

6' Perforated at bottom

AQUIFERS:

WATER LEVEL:

PUMPING EQUIPMENT: Type Jet pump H.P. 1
Capacity 100 G.P.M.

WELL TESTS:

Drawdown 6 to 8 ft. after _____ hours Pumping about 100 G.P.M.
Drawdown _____ ft. after _____ hours _____ G.P.M.

USE OF WATER Irrigation Temp. _____ °F. _____, 19.

SOURCE OF INFORMATION GR-2068

DRILLER or DIGGER Bill Howell Route 2, Box 304, Corvallis, Oregon

ADDITIONAL DATA:

Log _____ Water Level Measurements _____ Chemical Analysis _____ Aquifer Test _____

REMARKS: