

STATE ENGINEER
Salem, Oregon

Well Record

rent
2659

STATE WELL NO. 11/4W-18N
COUNTY Benton
APPLICATION NO. GR-3558

OWNER: A. L. Guerber


MAILING ADDRESS: Route 1, Box 428

LOCATION OF WELL: Owner's No. _____

CITY AND STATE: Corvallis, Oregon

SW $\frac{1}{4}$ SW $\frac{1}{4}$ Sec. 18 T. 11 ^{N.} S., R. 4 ^{W.} W.M.

Bearing and distance from section or subdivision
corner 2 ch. W. & 7.07 ch. N. from NW cor.
James Stewart D.L.C. # 49

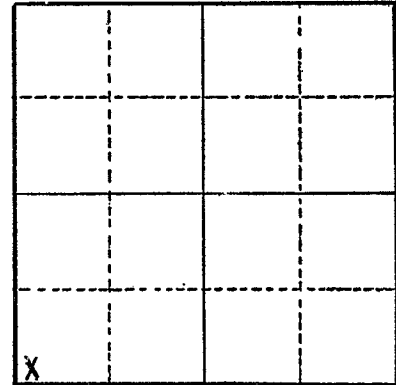

Section 18

Altitude at well _____

TYPE OF WELL: Drilled Date Constructed _____

Depth drilled 62 feet Depth cased 62 feet

CASING RECORD:

10 inch casing set to 62 feet

FINISH:

Perforations from 8 ft. to 62 ft.

AQUIFERS:

WATER LEVEL:

30 feet below surface

PUMPING EQUIPMENT: Type turbine H.P. 15
Capacity 220 G.P.M.

WELL TESTS:

Drawdown 15 ft. after _____ hours 350 G.P.M.
Drawdown _____ ft. after _____ hours _____ G.P.M.

USE OF WATER Irrigation Temp. _____ °F. _____, 19

SOURCE OF INFORMATION Well Registration Statement

DRILLER or DIGGER _____

ADDITIONAL DATA:

Log X Water Level Measurements _____ Chemical Analysis _____ Aquifer Test _____

REMARKS:

Log:

Clay
Sandy & gravel

Thickness	Depth to Bottom
50	12' - 14'
12' - 14'	0