

STATE ENGINEER
Salem, Oregon

Well Record


STATE WELL NO. 11/4W-18K(1)
COUNTY Benton
APPLICATION NO. GR-551

*Bent
2660*

OWNER: R. Vincent & Agnes J. Wood MAILING ADDRESS: 240 N. 16th Street
CITY AND STATE: Corvallis, Oregon

LOCATION OF WELL: Owner's No. 1
NW 1/4 SE 1/4 Sec. 18 T. 11 S., R. 4 W., W.M.

Bearing and distance from section or subdivision
corner 1700' & 1450' W. from SE corner of
Sec. 18

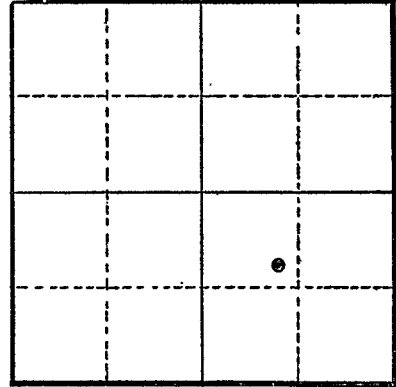

Section 18

Altitude at well 200

TYPE OF WELL: Drilled Date Constructed 7/30/50
Depth drilled 64' Depth cased 64'

CASING RECORD:

8"

FINISH:

AQUIFERS:

WATER LEVEL:

38'

PUMPING EQUIPMENT: Type Peerless turbine H.P. 5
Capacity 140 G.P.M.

WELL TESTS:

Drawdown ft. after hours G.P.M.
Drawdown ft. after hours G.P.M.

USE OF WATER Irrigation - 12 Ac. Temp. °F., 19.....

SOURCE OF INFORMATION GR-551

DRILLER or DIGGER -

ADDITIONAL DATA:

Log x Water Level Measurements Chemical Analysis Aquifer Test

REMARKS:

