

STATE ENGINEER
Salem, Oregon

Well Record

Bent
2663

STATE WELL NO. 11/4W-19R
COUNTY BENTON
APPLICATION NO. GR-2880

OWNER: A. D. and Marie R. Belnap


MAILING ADDRESS: Rt. 1, Box 466

LOCATION OF WELL: Owner's No. _____

CITY AND STATE: Corvallis, Oregon

SE $\frac{1}{4}$ SE $\frac{1}{4}$ Sec. 19 T. 11 ~~N~~ S, R. 4 ~~E~~ W, W.M.

Bearing and distance from section or subdivision corner N. 56° 0" E. 1156' from a 1" iron pipe.

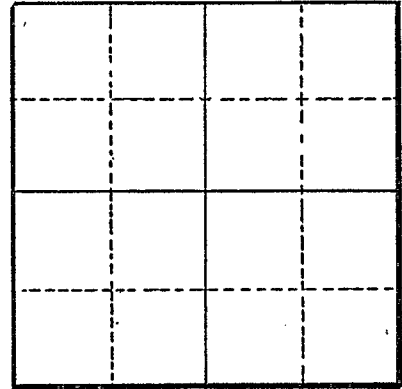

Section _____

Altitude at well _____

TYPE OF WELL: drilled Date Constructed 1943

Depth drilled 27 Depth cased 27

CASING RECORD:

5-inch

FINISH:

Slots size and number unknown from 11" to 27'

AQUIFERS:

WATER LEVEL:

9-feet

PUMPING EQUIPMENT: Type Pacific centrifugal pump H.P. 20
Capacity 375 G.P.M.

WELL TESTS:
Drawdown 2 ft. after _____ hours Pumping 400 G.P.M.
Drawdown _____ ft. after _____ hours _____ G.P.M.

USE OF WATER irrigation Temp. _____ °F. _____, 19____

SOURCE OF INFORMATION GR-2711
DRILLER or DIGGER Driller deceased

ADDITIONAL DATA:

Log _____ Water Level Measurements _____ Chemical Analysis _____ Aquifer Test _____

REMARKS: