

STATE ENGINEER
Salem, Oregon

Well Record

Bent
2664

STATE WELL NO. 11/4W-19Q
COUNTY BENTON
APPLICATION NO. GR-2607

OWNER: C. R. Hodges


MAILING ADDRESS: Rt. 1, Box 476 Garden Road

LOCATION OF WELL: Owner's No.

CITY AND STATE: Corvallis, Oregon

SW 1/4 SE 1/4 Sec. 19 T. 11 S., R. 4 W., W.M.

Bearing and distance from section or subdivision
corner S. 8° 57 1/2' W. 15.987 chains from most E. N.E.
corner J. H. Stewart DLC No. 49.

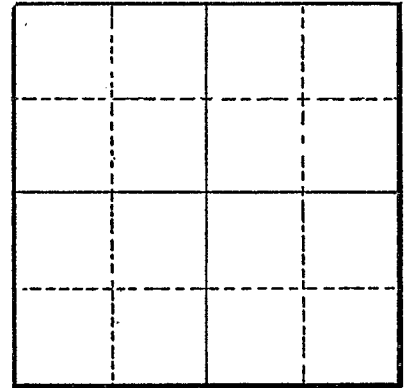

Section

Altitude at well

TYPE OF WELL: Drilled Date Constructed 1942

Depth drilled 44 Depth cased

CASING RECORD:

8-inch

FINISH:

AQUIFERS:

WATER LEVEL:

8-feet

PUMPING EQUIPMENT: Type Peerless Combination H.P. 5
Capacity 120 G.P.M.

WELL TESTS:

Drawdown 2 ft. after hours Pumping 150 G.P.M.
Drawdown ft. after hours G.P.M.

USE OF WATER Irrigation Temp. °F., 19

SOURCE OF INFORMATION GR-2474

DRILLER or DIGGER

ADDITIONAL DATA:

Log Water Level Measurements Chemical Analysis Aquifer Test

REMARKS: