

STATE ENGINEER
Salem, Oregon

Well Record

Bent
2666

STATE WELL NO. 11/4W-19Q
COUNTY BENTON
APPLICATION NO. GR-2879

OWNER: Goldie Marie Belnap


MAILING ADDRESS: Rt. 1, Box 466

LOCATION OF WELL: Owner's No. _____

CITY AND STATE: Corvallis, Oregon

SW $\frac{1}{4}$ SE $\frac{1}{4}$ Sec. 19 T. 11 S., R. 4 W., W.M.

Bearing and distance from section or subdivision corner S. 15° 10' E. 462' from 1 $\frac{1}{4}$ " pipe in the center of 60" maple stump, said pipe locating SW corner of J. S. Kendall DLC #48.

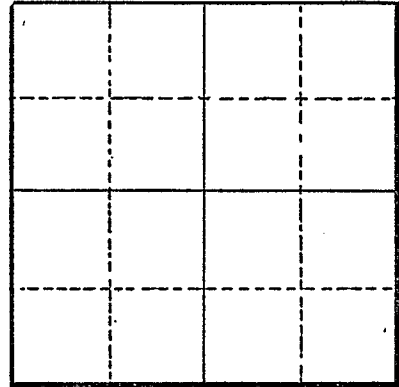

Section _____

Altitude at well _____

TYPE OF WELL: drilled Date Constructed 1942

Depth drilled 26 Depth cased 26

CASING RECORD:

5-inch

FINISH:

Size and number unknown from 11 to 26'

AQUIFERS:

WATER LEVEL:

8-feet

PUMPING EQUIPMENT: Type Pacific Centrifugal Pump H.P. 15
Capacity 275 G.P.M.

WELL TESTS:

Drawdown 3 ft. after _____ hours Pumping 275 G.P.M.
Drawdown _____ ft. after _____ hours _____ G.P.M.

USE OF WATER irrigation Temp. _____ °F., 19 _____

SOURCE OF INFORMATION GR-2710

DRILLER or DIGGER Driller deceased

ADDITIONAL DATA:

Log _____ Water Level Measurements _____ Chemical Analysis _____ Aquifer Test _____

REMARKS: