

STATE ENGINEER
Salem, Oregon

Well Record

Benton
2669
STATE WELL NO. 11/4W-19N(1)
COUNTY Benton
APPLICATION NO. GR-715

OWNER: Clyde S. Millsap


MAILING ADDRESS:

LOCATION OF WELL: Owner's No.

CITY AND STATE: Corvallis, Oregon

SW 1/4 SW 1/4 Sec. 19 T. 11 N. S. R. 4 W., W.M.

Bearing and distance from section or subdivision corner 3.7 chains east and 41.7 chains north of SW corner of James H. Stewart DLC #49

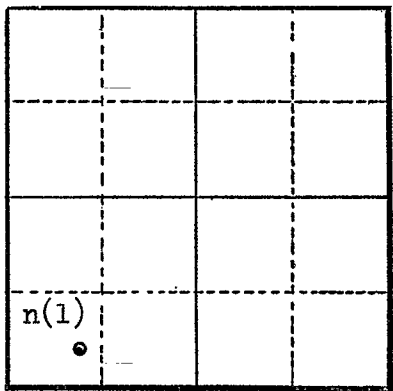

Section 19

Altitude at well 226' Interpolated

TYPE OF WELL: Drilled Date Constructed

Depth drilled 30' Depth cased 32'

CASING RECORD:

5" from surface to 32'

FINISH:

AQUIFERS:

WATER LEVEL:

14'

PUMPING EQUIPMENT: Type Gould Cent. - single phase elect. H.P. 5

Capacity 100 G.P.M.

WELL TESTS:

Drawdown 1 ft. after 225 hours G.P.M.

Drawdown ft. after hours G.P.M.

USE OF WATER Irrigation Temp. °F., 19

SOURCE OF INFORMATION GR-715

DRILLER or DIGGER

ADDITIONAL DATA:

Log Water Level Measurements Chemical Analysis Aquifer Test

REMARKS: