

STATE ENGINEER  
Salem, Oregon

# Well Record

*Bent*  
*2678* STATE WELL NO. 11/4W-19L(3)  
COUNTY Benton  
APPLICATION NO. GR-1771

GR- 1716

OWNER: Edward K. Vaughan


MAILING ADDRESS: 737 N. 31st

LOCATION OF WELL: Owner's No. \_\_\_\_\_

CITY AND STATE: Corvallis, Oregon

NE 1/4 SW 1/4 Sec. 19 T. 11 S., R. 4 W., W.M.

Bearing and distance from section or subdivision corner 990' W. & 206' S. from Center of Sec. 19

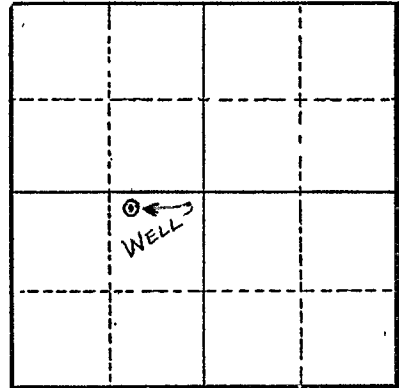

Section 19

Altitude at well 230'

TYPE OF WELL: Drilled Date Constructed 1951

Depth drilled 51' Depth cased 51'

### CASING RECORD:

6"

### FINISH:

Perforated from 40 to 51 ft.

### AQUIFERS:

### WATER LEVEL:

30'

PUMPING EQUIPMENT: Type F. M. shaft driven turbine H.P. 3  
Capacity 60 G.P.M.

### WELL TESTS:

Drawdown \_\_\_\_\_ ft. after \_\_\_\_\_ hours \_\_\_\_\_ G.P.M.  
Drawdown \_\_\_\_\_ ft. after \_\_\_\_\_ hours \_\_\_\_\_ G.P.M.

USE OF WATER Irrigation & Domestic Temp. \_\_\_\_\_ °F. \_\_\_\_\_, 19\_\_\_\_

SOURCE OF INFORMATION GR Record

DRILLER or DIGGER \_\_\_\_\_

### ADDITIONAL DATA:

Log N.A. Water Level Measurements \_\_\_\_\_ Chemical Analysis \_\_\_\_\_ Aquifer Test \_\_\_\_\_

### REMARKS:

Irrigation of 8.2 acres.