

STATE ENGINEER  
Salem, Oregon

# Well Record

*Bent* STATE WELL NO. 11/AM-19L(2)  
COUNTY Benton  
APPLICATION NO. GR-1680

GR- 1629

OWNER: James E. Garland


MAILING ADDRESS: Rt. 1, Box 452

LOCATION OF WELL: Owner's No. \_\_\_\_\_

CITY AND STATE: Corvallis, Oregon

NE 1/4 SW 1/4 Sec. 19 T. 11 S., R. 4 W., W.M.

Bearing and distance from section or subdivision corner 2650' S. & 100' W. from N 1/4 cor. Sec. 19

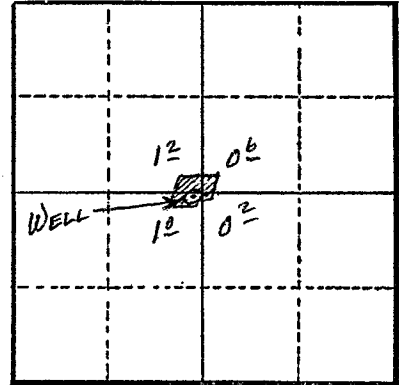

Section 19

Altitude at well 220'

TYPE OF WELL: Drilled Date Constructed 1947

Depth drilled 65' Depth cased 60'

CASING RECORD:

6"

FINISH:

Perforated from 40 to 60 ft.

AQUIFERS:

WATER LEVEL:

20'

PUMPING EQUIPMENT: Type Jet boost Cent. 1" x 1 1/2" H.P. 2  
Capacity 30 G.P.M.

WELL TESTS:

Drawdown 5 ft. after \_\_\_\_\_ hours 30 G.P.M.

Drawdown \_\_\_\_\_ ft. after \_\_\_\_\_ hours \_\_\_\_\_ G.P.M.

USE OF WATER Irrigation & Domestic Temp. \_\_\_\_\_ °F., 19 \_\_\_\_\_

SOURCE OF INFORMATION GR Record

DRILLER or DIGGER Skillings

ADDITIONAL DATA:

Log N.A. Water Level Measurements \_\_\_\_\_ Chemical Analysis \_\_\_\_\_ Aquifer Test \_\_\_\_\_

REMARKS:

Irrigation of 3 acres.