

OBSERVATION WELL

STATE ENGINEER
Salem, Oregon

Well Record


Bent STATE WELL NO. 11/4W-19L(1)
COUNTY Benton
2673 APPLICATION NO. GR-830

Now OREGON STATE UNIVERSITY

OWNER: Oregon Dairy Breeder's Ass'n. MAILING ADDRESS:
LOCATION OF WELL: Owner's No. CITY AND STATE: Corvallis, Oregon

NE 1/4 SW 1/4 Sec. 19 T. 11 S., R. 4 W., W.M.

Bearing and distance from section or subdivision corner N. 5909' W. 1055' of SW corner J. S. Kendall DLC #48

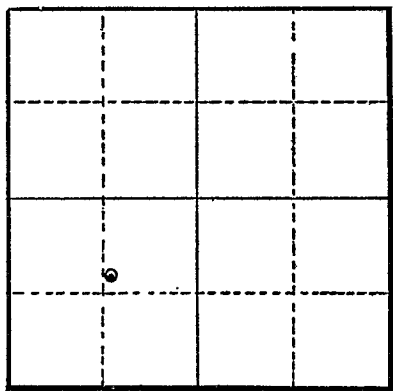

Section 19

Altitude at well 220'

TYPE OF WELL: Drilled Date Constructed 1947

Depth drilled 280 Depth cased

CASING RECORD:
8"

FINISH:
-

AQUIFERS:
-

WATER LEVEL:
29'

PUMPING EQUIPMENT: Type Peerless 4 1/2' Turbine H.P. 5 Elec.
Capacity G.P.M.

WELL TESTS:
Drawdown 17.5 ft. after hours 250 G.P.M.
Drawdown ft. after hours G.P.M.

USE OF WATER Irrigation Temp. °F., 19

SOURCE OF INFORMATION Owner

DRILLER or DIGGER

ADDITIONAL DATA:
Log NA Water Level Measurements Chemical Analysis Aquifer Test

REMARKS: