

STATE ENGINEER  
Salem, Oregon

# Well Record

Bent  
2675  
STATE WELL NO. 11/4W-19J(2)  
COUNTY Benton  
APPLICATION NO. GR-1379

GR- 1336

OWNER: Annie Emma & Mary Agnes Pilkington

MAILING ADDRESS:


LOCATION OF WELL: Owner's No.

CITY AND STATE:

Corvallis, Oregon

NE 1/4 SE 1/4 Sec. 19 T. 11 S. R. 4 W., W.M.

Bearing and distance from section or subdivision corner 21.5 ch. N. & 33 ch. E. from SW cor. of Jehiels S. Kendall DIC #48.

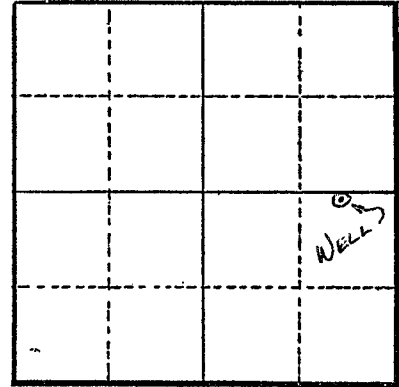

Section 19

Altitude at well 210 ft.

TYPE OF WELL: Drilled Date Constructed 1941

Depth drilled 47 ft. Depth cased 47 ft.

### CASING RECORD:

4 inch

### FINISH:

Perforated

### AQUIFERS:

### WATER LEVEL:

28 ft.

PUMPING EQUIPMENT: Type Westco H.P. 1/2  
Capacity 15 G.P.M.

### WELL TESTS:

Drawdown ft. after hours G.P.M.  
Drawdown ft. after hours G.P.M.

USE OF WATER Irrigation Temp. °F. 19

SOURCE OF INFORMATION G. R. Record

DRILLER or DIGGER Mr. Knutson

### ADDITIONAL DATA:

Log N.A. Water Level Measurements Chemical Analysis Aquifer Test

### REMARKS:

Irrigation of 13.4 acres.