

OWNER: C. R. Crist


MAILING ADDRESS:

LOCATION OF WELL: Owner's No. 1

CITY AND STATE: Corvallis, Oregon

NE 1/4 SE 1/4 Sec. 19 T. 11 S., R. 4 W., W.M.

Bearing and distance from section or subdivision corner 26.764 chains west & 8.94 chains north of SE corner DLC #48

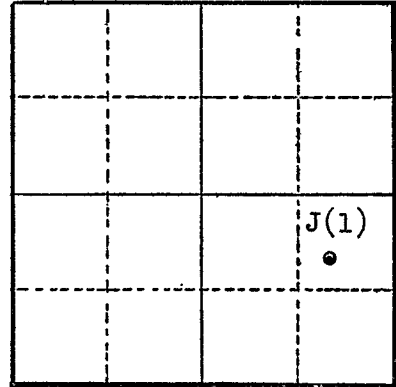

Section 19

Altitude at well 200' Interpolated

TYPE OF WELL: Drilled Date Constructed 1952

Depth drilled 33 Depth cased 33

CASING RECORD:

6" casing set from 0 to 33 feet.

FINISH:

unknown

AQUIFERS:

unknown

WATER LEVEL:

11 feet below land surface

PUMPING EQUIPMENT: Type Pacific centrifugal 4" H.P. 10  
Capacity unknown G.P.M.

WELL TESTS:

Drawdown unknown ft. after \_\_\_\_\_ hours pumping 200 G.P.M.  
Drawdown \_\_\_\_\_ ft. after \_\_\_\_\_ hours \_\_\_\_\_ G.P.M.

USE OF WATER Irrigation 24.8 acres Temp. \_\_\_\_\_ °F., 19\_\_\_\_\_

SOURCE OF INFORMATION Registration statement GR-293

DRILLER or DIGGER Raymond C. Gellatly, Philomath, Oregon

ADDITIONAL DATA:

Log No Water Level Measurements \_\_\_\_\_ Chemical Analysis \_\_\_\_\_ Aquifer Test \_\_\_\_\_

REMARKS: