

STATE ENGINEER  
Salem, Oregon

# Well Record

STATE WELL NO. 11/4W-19F  
COUNTY Benton  
APPLICATION NO. GR-3375

OWNER: J. H. and Florence M. Kimmel


MAILING ADDRESS: Route 1, Box 543

LOCATION OF WELL: Owner's No. \_\_\_\_\_

CITY AND STATE: Oregon

SE 1/4 NW 1/4 Sec. 19 T. 11 N. S. R. 4 E. W., W.M.

Bearing and distance from section or subdivision corner 51° 21' East 30.72 <sup>ch.</sup> feet from the NW corner, DLC 48

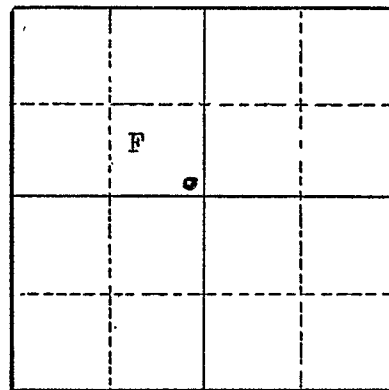

Section 19

Altitude at well 220 feet

TYPE OF WELL: Drilled Date Constructed unk

Depth drilled 52 feet Depth cased 52 feet

### CASING RECORD:

6-inch casing set from 0 to 52 feet

### FINISH:

38 to 46 feet

### AQUIFERS:

sand, gravel, ~~clay~~

### WATER LEVEL:

18 feet

PUMPING EQUIPMENT: Type \_\_\_\_\_ Jet Type \_\_\_\_\_ H.P. \_\_\_\_\_  
Capacity 70 G.P.M.

### WELL TESTS:

Drawdown 2 ft. after \_\_\_\_\_ hours 70 G.P.M.  
Drawdown \_\_\_\_\_ ft. after \_\_\_\_\_ hours \_\_\_\_\_ G.P.M.

USE OF WATER Irrigation Temp. \_\_\_\_\_ °F. \_\_\_\_\_, 19

SOURCE OF INFORMATION GR-4078

DRILLER or DIGGER \_\_\_\_\_

### ADDITIONAL DATA:

Log x Water Level Measurements \_\_\_\_\_ Chemical Analysis \_\_\_\_\_ Aquifer Test \_\_\_\_\_

### REMARKS:

Silt loam and clay non-water bearing	0	38	38
Sand and gravel-water bearing	38	52	14