

STATE ENGINEER
Salem, Oregon


Well Record

Bent
2678
STATE WELL NO. 11/4W-19F(1)
COUNTY Benton
APPLICATION NO. GR-562

OWNER: Harold Chance MAILING ADDRESS: P. O. Box 669

LOCATION OF WELL: Owner's No. _____ CITY AND STATE: Corvallis, Oregon

SE 1/4 NW 1/4 Sec. 19 T. 11 ^{N.} S., R. 4 ^{E.} W., W.M.
Bearing and distance from section or subdivision
corner 100' N. 70° W.; S. 20° W. from E. property
corner 2860' W. & 2300' S. from NE corner
Section 19

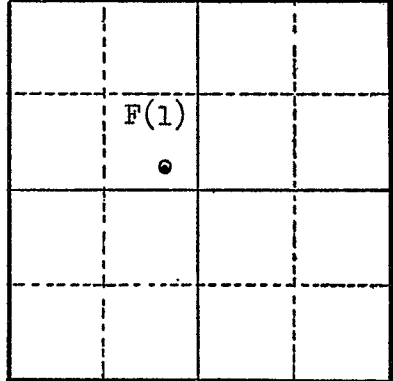

Section 19

Altitude at well 215

TYPE OF WELL: Drilled Date Constructed Prior to '55

Depth drilled 40 Depth cased 8

CASING RECORD:

6"

FINISH:

AQUIFERS:

WATER LEVEL:

25'

PUMPING EQUIPMENT: Type Jacuzzi Turbine H.P. 3
Capacity 50 G.P.M.

WELL TESTS:

Drawdown _____ ft. after _____ hours _____ G.P.M.
Drawdown _____ ft. after _____ hours _____ G.P.M.

USE OF WATER Irrigation - 3.5 acres Temp. _____ °F. _____, 19_____

SOURCE OF INFORMATION GR-562

DRILLER or DIGGER -

ADDITIONAL DATA:

Log - Water Level Measurements _____ Chemical Analysis _____ Aquifer Test _____

REMARKS: