

STATE ENGINEER  
Salem, Oregon

# Well Record


*Bent* STATE WELL NO. 11/LW-19B  
*2684* COUNTY BENTON  
APPLICATION NO. GR-2784

OWNER: Lynn Gallagher MAILING ADDRESS: Rt. 1, Box 437

LOCATION OF WELL: Owner's No. \_\_\_\_\_ CITY AND STATE: Corvallis, Oregon

NW 1/4 NE 1/4 Sec. 19 T. 11 N. S., R. 4 E. W., W.M.

Bearing and distance from section or subdivision corner 1200' S.

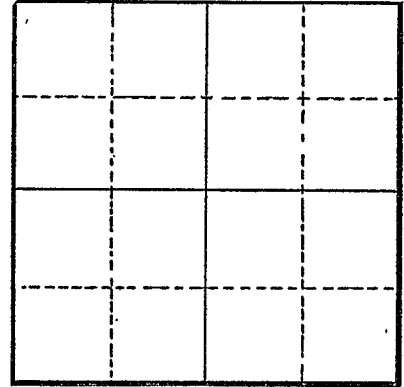

Section \_\_\_\_\_

Altitude at well \_\_\_\_\_

TYPE OF WELL: drilled Date Constructed 1940

Depth drilled 55 Depth cased 45

### CASING RECORD:

4-inch

### FINISH:

### AQUIFERS:

Willamette, clay, sand and gravel

### WATER LEVEL:

PUMPING EQUIPMENT: Type Shasta combination H.P. 1  
Capacity 15 G.P.M.

### WELL TESTS:

Drawdown \_\_\_\_\_ ft. after \_\_\_\_\_ hours Pumping 15 G.P.M.  
Drawdown \_\_\_\_\_ ft. after \_\_\_\_\_ hours \_\_\_\_\_ G.P.M.

USE OF WATER irrigation Temp. \_\_\_\_\_ °F. \_\_\_\_\_, 19

SOURCE OF INFORMATION GR-2631

DRILLER or DIGGER C. L. Schillings

### ADDITIONAL DATA:

Log  Water Level Measurements \_\_\_\_\_ Chemical Analysis \_\_\_\_\_ Aquifer Test \_\_\_\_\_

### REMARKS:

Willamette 2  
Clay 20  
Sand (pure) 2  
Clay 11  
Gravel 10