

STATE ENGINEER
Salem, Oregon

Well Record

STATE WELL NO. 11/4W-19A(1)
COUNTY Benton
APPLICATION NO. GR-88

OWNER: Emil B. Schlinkmeier


MAILING ADDRESS: _____

LOCATION OF WELL: Owner's No. _____

CITY AND STATE: Corvallis, Oregon

NE 1/4 NE 1/4 Sec. 19 T. 11 S., R. 4 W., W.M.

Bearing and distance from section or subdivision corner 13 chains south and 18 chains west of NE corner of Section 19.

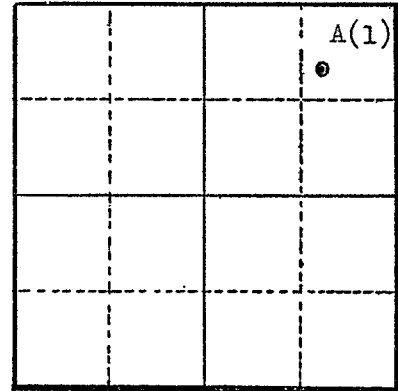

Section 19

Altitude at well 250' Interpolated

TYPE OF WELL: Drilled Date Constructed 10/20/50

Depth drilled 52' Depth cased 54'

CASING RECORD:

8" casing set from 0 to 54'

FINISH:

10" x 1/4" perforations - 4 perforations /foot from 42 feet to 54 feet.

AQUIFERS:

Gravel from 24' to 55'

WATER LEVEL:

40' below land surface ?? 10/27/50

PUMPING EQUIPMENT: Type Jacuzzi jet

HP5

Capacity 75 G.P.M.

WELL TESTS:

Drawdown _____ ft. after _____ hours 200 G.P.M.

Drawdown _____ ft. after _____ hours _____ G.P.M.

USE OF WATER Irrigation 5 1/2 acres Temp. _____ °F., 19

SOURCE OF INFORMATION Registration Statement GR-88

DRILLER or DIGGER _____

ADDITIONAL DATA:

Log Water Level Measurements _____ Chemical Analysis _____ Aquifer Test _____

REMARKS:

