

STATE ENGINEER  
Salem, Oregon

# Well Record

STATE WELL NO. 11/4W-20Q  
COUNTY BENTON  
APPLICATION NO. GR-2871

OWNER: Ben D. Halsey


MAILING ADDRESS: Rt. 1, Box 480

LOCATION OF WELL: Owner's No.

CITY AND STATE: Corvallis, Oregon

SW 1/4 SE 1/4 Sec. 20 T. 11 N. S., R. 4 E. W.M.

Bearing and distance from section or subdivision corner 700' N. 30' E.

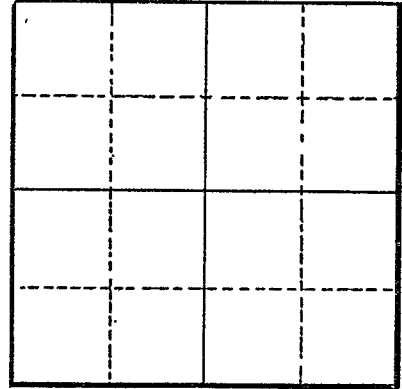

Section

Altitude at well

TYPE OF WELL: drilled Date Constructed 1948

Depth drilled 30 Depth cased

### CASING RECORD:

12-inch

### FINISH:

### AQUIFERS:

### WATER LEVEL:

18-feet

PUMPING EQUIPMENT: Type Fairbanks Morse Centrifugal H.P. 10  
Capacity 600 G.P.M.

### WELL TESTS:

Drawdown none ft. after hours Pumping 500 G.P.M.  
Drawdown ft. after hours G.P.M.

USE OF WATER irrigation Temp. °F. 19

SOURCE OF INFORMATION GR-2678

DRILLER or DIGGER Burton Asbahr, Rt. 1, Corvallis, Oregon

### ADDITIONAL DATA:

Log Water Level Measurements Chemical Analysis Aquifer Test

### REMARKS: