

# Well Record


*Bent* STATE WELL NO. 11/4W-29-B  
COUNTY Benton  
*2787* APPLICATION NO. GR-3639

OWNER: Harold L. Marchel MAILING ADDRESS: 2723 Jackson

LOCATION OF WELL: Owner's No. 1 CITY AND STATE: Corvallis, Oregon

NW  $\frac{1}{4}$  NE  $\frac{1}{4}$  Sec. 29 T. 11 S., R. 4 W., W.M.

Bearing and distance from section or subdivision corner 2150 feet West and 1000 feet South of NE Corner, Section 29

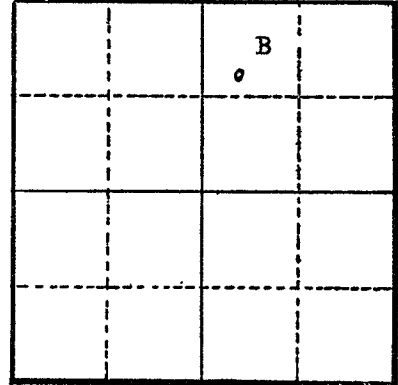

Section 29

Altitude at well \_\_\_\_\_

TYPE OF WELL: Drilled Date Constructed prior to 1953

Depth drilled 32 feet Depth cased \_\_\_\_\_

CASING RECORD:

6 inch casing

FINISH:

AQUIFERS:

WATER LEVEL:

6 feet

PUMPING EQUIPMENT: Type Fairbanks Morris H.P. 10  
Capacity \_\_\_\_\_ G.P.M.

WELL TESTS:

Drawdown \_\_\_\_\_ ft. after \_\_\_\_\_ hours \_\_\_\_\_ G.P.M.

Drawdown \_\_\_\_\_ ft. after \_\_\_\_\_ hours \_\_\_\_\_ G.P.M.

USE OF WATER Domestic and Irrigation Temp. \_\_\_\_\_ °F., 19\_\_\_\_\_

SOURCE OF INFORMATION GR-4136

DRILLER or DIGGER \_\_\_\_\_

ADDITIONAL DATA:

Log (NA) Water Level Measurements \_\_\_\_\_ Chemical Analysis \_\_\_\_\_ Aquifer Test \_\_\_\_\_

REMARKS: