

STATE ENGINEER  
Salem, Oregon

# Well Record

STATE WELL NO. 11/LW-29C  
COUNTY Benton  
APPLICATION NO. GR-3338

OWNER: Nelson Lee Gilmour


MAILING ADDRESS: Route 1

LOCATION OF WELL: Owner's No. \_\_\_\_\_

CITY AND STATE: Corvallis, Oregon

NE  $\frac{1}{4}$  NW  $\frac{1}{4}$  Sec. 29 T. 11 S., R. 4 W., W.M.

Bearing and distance from section or subdivision corner 1206' S 16° 30' W

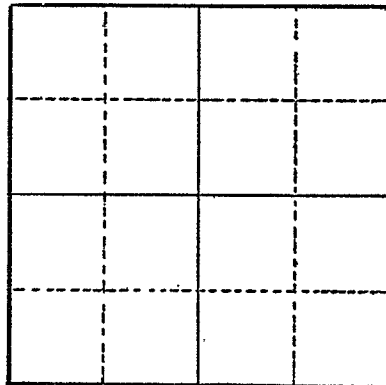

Section \_\_\_\_\_

Altitude at well \_\_\_\_\_

TYPE OF WELL: drilled Date Constructed 1948

Depth drilled 34' Depth cased 34'

### CASING RECORD:

10"

### FINISH:

perforated, length, size and number unknown

### AQUIFERS:

### WATER LEVEL:

16'

PUMPING EQUIPMENT: Type 3 x 2 Centrifugal H.P. 15  
Capacity 500 G.P.M.

### WELL TESTS:

Drawdown 2 ft. after \_\_\_\_\_ hours pumping 500 G.P.M.

Drawdown \_\_\_\_\_ ft. after \_\_\_\_\_ hours \_\_\_\_\_ G.P.M.

USE OF WATER Irrigation Temp. \_\_\_\_\_ °F. \_\_\_\_\_, 19\_\_\_\_

SOURCE OF INFORMATION GR-3092

DRILLER or DIGGER \_\_\_\_\_

### ADDITIONAL DATA:

Log \_\_\_\_\_ Water Level Measurements \_\_\_\_\_ Chemical Analysis \_\_\_\_\_ Aquifer Test \_\_\_\_\_

### REMARKS: