

STATE ENGINEER
Salem, Oregon


Well Record

STATE WELL NO. 11/4W-30C
COUNTY Benton
2797 APPLICATION NO. GR-3869

OWNER: James H. Johnson MAILING ADDRESS: Route 1

LOCATION OF WELL: Owner's No. _____ CITY AND STATE: Corvallis, Oregon

NE 1/4 NW 1/4 Sec. 30 T. 11 N. S., R. 4 E. W., W.M.
Bearing and distance from section or subdivision
corner 21.82 chs. E. & 9.8 chs. N. of SW Cor.
J. H. Stewart D.L.C. 49

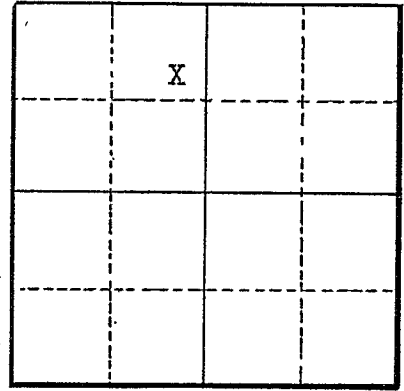

Section 30

Altitude at well _____

TYPE OF WELL: Drilled Date Constructed _____

Depth drilled 32 feet Depth cased 32 feet

CASING RECORD:

FINISH:

AQUIFERS:

WATER LEVEL:

10 feet below surface

PUMPING EQUIPMENT: Type General Electric H.P. 10
Capacity 300 G.P.M.

WELL TESTS:

Drawdown _____ ft. after _____ hours _____ G.P.M.
Drawdown _____ ft. after _____ hours _____ G.P.M.

USE OF WATER Irrigation Temp. _____ °F. _____, 19.

SOURCE OF INFORMATION Well Registration Statement Cert. # GR-3521

DRILLER or DIGGER _____

ADDITIONAL DATA:

Log _____ Water Level Measurements _____ Chemical Analysis _____ Aquifer Test _____

REMARKS: