

STATE ENGINEER
Salem, Oregon

Well Record

STATE WELL NO. 11/4W-30C(1)
COUNTY Benton
APPLICATION NO. GR-540

OWNER: Sam L. Millsap

MAILING ADDRESS:


LOCATION OF WELL: Owner's No. #1

CITY AND STATE:

Corvallis, Oregon

NE 1/4 NW 1/4 Sec. 30 T. 11 S. R. 4 W., W.M.

Bearing and distance from section or subdivision corner 13.9 chains E and 26.2 chains N of SW corner J. H. Stewart DLC #49

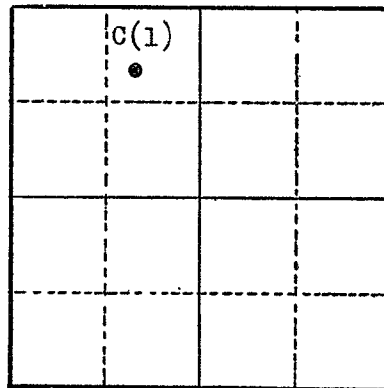

Section 30

Altitude at well 210 Interpolated

TYPE OF WELL: Drilled Date Constructed 1937

Depth drilled 32' Depth cased 32'

CASING RECORD:

8"

FINISH:

AQUIFERS:

WATER LEVEL:

14'

PUMPING EQUIPMENT: Type Gould centrifugal H.P. 15
Capacity 500 G.P.M.

WELL TESTS:

Drawdown 1 ft. after _____ hours 500 G.P.M.
Drawdown _____ ft. after _____ hours _____ G.P.M.

USE OF WATER Irrigation - 36.5 Acres Temp. _____ °F., 19

SOURCE OF INFORMATION GR-540

DRILLER or DIGGER -

ADDITIONAL DATA:

Log - Water Level Measurements _____ Chemical Analysis _____ Aquifer Test _____

REMARKS: