

OWNER: Vernon L. Martin


MAILING ADDRESS: Rt. 1, Box 513

LOCATION OF WELL: Owner's No. _____

CITY AND STATE: Corvallis, Oregon

NW 1/4 NW 1/4 Sec. 30 T. 11 N. 4 E. W., W.M.

Bearing and distance from section or subdivision corner 1125' S. and 200' E.

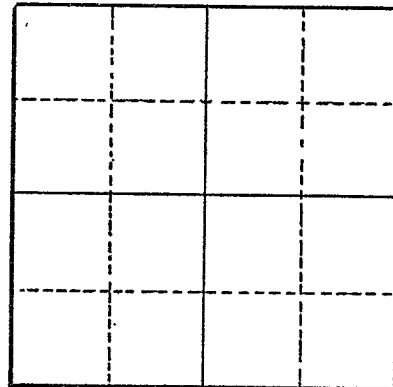

Section _____

Altitude at well _____

TYPE OF WELL: Drilled Date Constructed 1942

Depth drilled 35 Depth cased 30

CASING RECORD:

4-inch

FINISH:

6' to 10' at bottom perforated

AQUIFERS:

Chehalis, sand, gravel

WATER LEVEL:

18-feet

PUMPING EQUIPMENT: Type _____

H.P. _____

Capacity _____ G.P.M.

WELL TESTS:

Drawdown 3 ft. after _____ hours Pumping 125 G.P.M.

Drawdown _____ ft. after _____ hours _____ G.P.M.

USE OF WATER Irrigation Temp. _____ °F. _____, 19_____

SOURCE OF INFORMATION GR-2460

DRILLER or DIGGER _____

ADDITIONAL DATA:

Log 2 Water Level Measurements _____ Chemical Analysis _____ Aquifer Test _____

REMARKS:

Chehalis 10
Sand 10
Gravel 15