

STATE ENGINEER
Salem, Oregon

Well Record

STATE WELL NO. 11/4W-30D
COUNTY BENTON
APPLICATION NO. GR-2382

Ben & 2801

OWNER: O. Eugene Smith


MAILING ADDRESS: Rt. 1, Box 515

LOCATION OF WELL: Owner's No. _____

CITY AND STATE: Corvallis, Oregon

NW $\frac{1}{4}$ NW $\frac{1}{4}$ Sec. 30 T. 11 ^N S, R. 4 ^E W., W.M.

Bearing and distance from section or subdivision corner 1056' S. & 165' E.

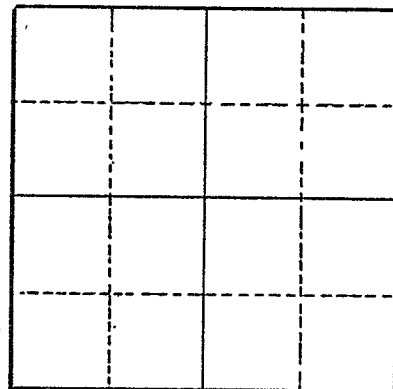

Section _____

Altitude at well _____

TYPE OF WELL: Drilled Date Constructed 1950

Depth drilled 34 Depth cased 30

CASING RECORD:

4-inch

FINISH:

1/2" Drilled perforations from 20' to 30'

AQUIFERS:

Chehalis soil, Sand and Gravel

WATER LEVEL:

12-feet

PUMPING EQUIPMENT: Type Gardner-Denver Centrifugal H.P. 7 1/2
Capacity 180 G.P.M.

WELL TESTS:

Drawdown 5 ft. after _____ hours Pumping 120 G.P.M.
Drawdown _____ ft. after _____ hours _____ G.P.M.

USE OF WATER Irrigation Temp. _____ °F., 19 _____

SOURCE OF INFORMATION GR-2264

DRILLER or DIGGER C. L. Skillings, Corvallis, Oregon

ADDITIONAL DATA:

Log Water Level Measurements _____ Chemical Analysis _____ Aquifer Test _____

REMARKS:

Chehalis soil 15
Sand 5
Gravel 14