

STATE ENGINEER  
Salem, Oregon

# Well Record

STATE WELL NO. 11/LW-30F  
COUNTY Benton  
APPLICATION NO. GR-3455

OWNER: Grace E. Burris


MAILING ADDRESS: Box 136

LOCATION OF WELL: Owner's No. \_\_\_\_\_

CITY AND STATE: Jefferson, Oregon

SE 1/4 NW 1/4 Sec. 30 T. 11 N. S., R. 4 E. W., W.M.

Bearing and distance from section or subdivision corner 1668 chs N. 35° 19'E.

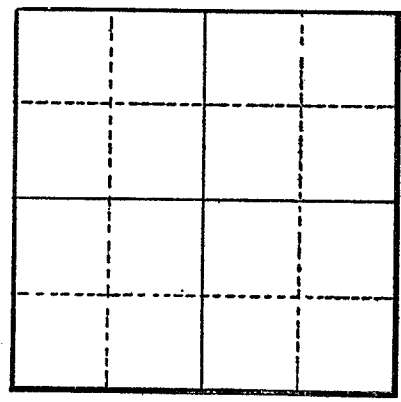

Section .....

Altitude at well .....

TYPE OF WELL: drilled Date Constructed 1944

Depth drilled 32' Depth cased 32'

### CASING RECORD:

6"

### FINISH:

8' perforated pipe - 1/2" opening 3' funnel shaped screen

### AQUIFERS:

chehalis, sand and gravel (River bottom)

### WATER LEVEL:

8'

PUMPING EQUIPMENT: Type Gould combination H.P. 2 1/2  
Capacity 70 G.P.M.

### WELL TESTS:

Drawdown 1 ft. after \_\_\_\_\_ hours pumping 70 G.P.M.  
Drawdown \_\_\_\_\_ ft. after \_\_\_\_\_ hours \_\_\_\_\_ G.P.M.

USE OF WATER Irrigation Temp. \_\_\_\_\_ °F. \_\_\_\_\_, 19\_\_\_\_

SOURCE OF INFORMATION GR-3196

DRILLER or DIGGER W. M. Slate, Tangent, Oregon

### ADDITIONAL DATA:

Log x Water Level Measurements \_\_\_\_\_ Chemical Analysis \_\_\_\_\_ Aquifer Test \_\_\_\_\_

### REMARKS:

Chehalis 20  
Sand & Gravel (River bottom) 12