

Bent
2803

OWNER: Clyde S. Millsap


MAILING ADDRESS: 308 N. 17th

LOCATION OF WELL: Owner's No. #2

CITY AND STATE: Corvallis, Oregon

SE 1/4 NW 1/4 Sec. 30 T. 11 N. S., R. 4 W. W.M.

Bearing and distance from section or subdivision
corner 7.5 chains E. & 17.9 chains N. of SW
corner of DLC #49 James H. Stewart

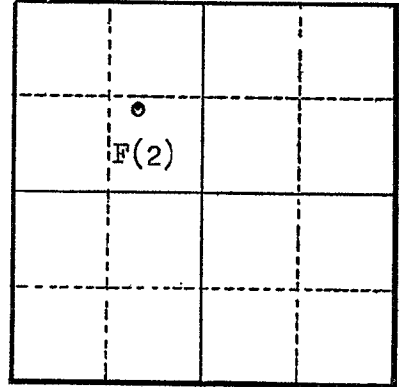

Altitude at well _____

TYPE OF WELL: Drilled Date Constructed 1945

Depth drilled 30' Depth cased 32'

Section 30

CASING RECORD:

4" from surface to 32'

FINISH:

AQUIFERS:

WATER LEVEL:

14'

PUMPING EQUIPMENT: Type Gould cent. - 1 phase elect. H.P. 7 1/2
Capacity 150 G.P.M.

WELL TESTS:

Drawdown 1 ft. after _____ hours 225 G.P.M.

Drawdown _____ ft. after _____ hours _____ G.P.M.

USE OF WATER Irrigation Temp. _____ °F. _____, 19_____

SOURCE OF INFORMATION GR-714

DRILLER or DIGGER _____

ADDITIONAL DATA:

Log _____ Water Level Measurements _____ Chemical Analysis _____ Aquifer Test _____

REMARKS: