

STATE ENGINEER
Salem, Oregon

Well Record

STATE WELL NO. 11/4W-30M(1)
COUNTY Benton
APPLICATION NO. GR-713

OWNER: Clyde S. Millsap


MAILING ADDRESS: 308 N. 17th

LOCATION OF WELL: Owner's No. #1

CITY AND STATE: Corvallis, Oregon

NW 1/4 SW 1/4 Sec. 30 T. 11 S., R. 4 W., W.M.

Bearing and distance from section or subdivision
corner 3.2 chains west & 7.7 chains south of
SW corner of James H. Stewart DLC #49

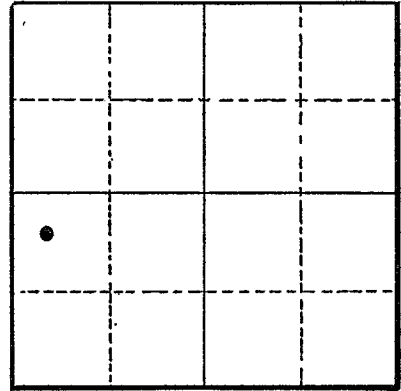

Section 30

Altitude at well 210' Interpolated

TYPE OF WELL: Drilled Date Constructed 1945

Depth drilled 30' Depth cased 32'

CASING RECORD:

5" from surface to 32'

FINISH:

AQUIFERS:

WATER LEVEL:

10'

PUMPING EQUIPMENT: Type Gould cent. - 1 phase elect. H.P. 5

Capacity 100 G.P.M.

WELL TESTS:

Drawdown 1 ft. after _____ hours 225 G.P.M.

Drawdown _____ ft. after _____ hours _____ G.P.M.

USE OF WATER Irrigation Temp. _____ °F. 19

SOURCE OF INFORMATION GR-713

DRILLER or DIGGER

ADDITIONAL DATA:

Log _____ Water Level Measurements _____ Chemical Analysis _____ Aquifer Test _____

REMARKS: