

STATE ENGINEER
Salem, Oregon


Well Record

Bent
3019 STATE WELL NO. 11/5W-10
COUNTY Benton
APPLICATION NO. GR-3754

OWNER: Alice Livingston MAILING ADDRESS: Route 1, Box 360

LOCATION OF WELL: Owner's No. _____ CITY AND STATE: Corvallis, Oregon

SW $\frac{1}{4}$ SE $\frac{1}{4}$ Sec. 1 T. 11 ^{N.} S., R. 5 ^{E.} W., W.M.
Bearing and distance from section or subdivision
corner Approx. 43 ch. E. & 13.4 ch. N. of SW cor.
Sec. 1

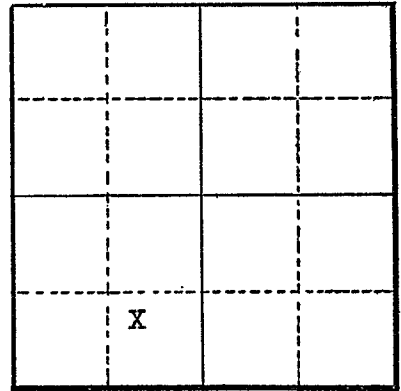

Section 1

Altitude at well _____

TYPE OF WELL: Drilled Date Constructed 1948

Depth drilled 50 feet Depth cased 50 feet

CASING RECORD:

4 inch casing set to 50 feet

FINISH:

AQUIFERS:

WATER LEVEL:

PUMPING EQUIPMENT: Type Jacuzzi combination H.P. 3/4
Capacity 14 G.P.M.

WELL TESTS:
Drawdown _____ ft. after _____ hours _____ G.P.M.
Drawdown _____ ft. after _____ hours _____ G.P.M.

USE OF WATER Irrigation Temp. _____ °F., 19_____

SOURCE OF INFORMATION Well Registration Statement

DRILLER or DIGGER Claude Shaffer

ADDITIONAL DATA:
Log _____ Water Level Measurements _____ Chemical Analysis _____ Aquifer Test _____

REMARKS:

3415