

STATE ENGINEER
Salem, Oregon

Well Record

Bent STATE WELL NO. 11/5W-11E
COUNTY Benton
APPLICATION NO. GR-1418

GR- 1372

OWNER: Clarence E. & Myrtle Hill Newton

MAILING ADDRESS: Rt. 1, Box 278


LOCATION OF WELL: Owner's No. #1

CITY AND STATE: Corvallis, Oregon

SW 1/4 NW 1/4 Sec. 11 T. 11 S., R. 5 W., W.M.

Bearing and distance from section or subdivision

corner 970' E. & 620' N. from W 1/4 cor. Sec. 11

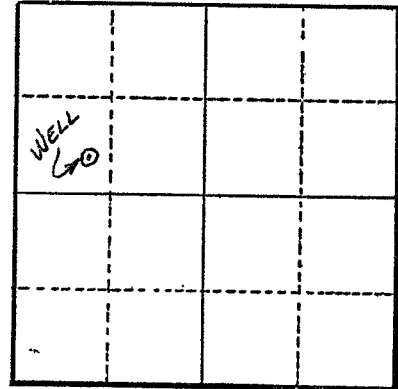

Section 11

Altitude at well

TYPE OF WELL: Drilled Date Constructed 1950

Depth drilled 110' Depth cased 20'

CASING RECORD:

6" steel

FINISH:

AQUIFERS:

Basalt rock - water bearing at 90 ft.

WATER LEVEL:

6'

PUMPING EQUIPMENT: Type F. M. turbine

H.P. 5

Capacity 75 G.P.M.

WELL TESTS:

Drawdown 84 ft. after 75 hours G.P.M.

Drawdown ft. after hours G.P.M.

USE OF WATER Irrigation Temp. °F. 19

SOURCE OF INFORMATION G. R. Record

DRILLER or DIGGER Frank Skillings

ADDITIONAL DATA:

Log N.A. Water Level Measurements Chemical Analysis Aquifer Test

REMARKS:

Irrigation of 26 acres.