

STATE ENGINEER  
Salem, Oregon

# Well Record

Benton STATE WELL NO. 11/5W-12B  
COUNTY Benton  
3391 APPLICATION NO. GR-4234

OWNER: Harold James Jensen

MAILING ADDRESS: Route 1, Box 361


LOCATION OF WELL: Owner's No.

CITY AND STATE: Corvallis, Oregon

NW 1/4 NE 1/4 Sec. 12 T. 11 S., R. 5 W., W.M.

Bearing and distance from section or subdivision

corner 185.4 ft. N. 40° 04' E. of E 1/4 NE Cor. Cl. 38

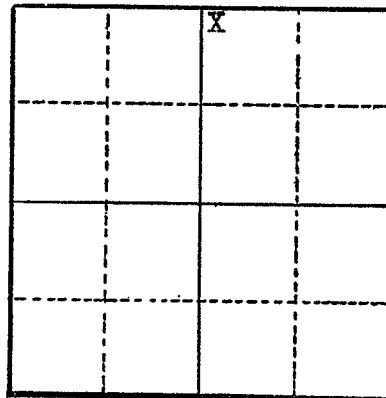

Section 12

Altitude at well

TYPE OF WELL: Drilled Date Constructed 6/15/55

Depth drilled 58 ft. Depth cased 35 ft.

### CASING RECORD:

6 in. .280" thickness from surface to 23.5 feet  
5 inch (liner) .250" thickness from surface to 35 feet

### FINISH:

4 - 1/2" x 12" (liner perforated) from 23 to 31 feet

### AQUIFERS:

### WATER LEVEL:

15 feet below surface

PUMPING EQUIPMENT: Type Homart (sears) deep well jet H.P. 1  
Capacity 1610 gph

### WELL TESTS:

Drawdown 12 ft. after 30 hours G.P.M.

Drawdown ft. after hours G.P.M.

USE OF WATER Irrigation & Domestic Temp. °F. 19

SOURCE OF INFORMATION Well Registration Statement Cert. # GR-3773

DRILLER or DIGGER Gilbert A. Pruitt

### ADDITIONAL DATA:

Log Water Level Measurements Chemical Analysis Aquifer Test

### REMARKS: