

STATE ENGINEER  
Salem, Oregon

# Well Record

STATE WELL NO. 11/5W-23L  
COUNTY BENTON  
APPLICATION NO. GR-2843

OWNER: Herbert Reeves Simard


MAILING ADDRESS: Rt. 4, Box 285 Highlandway

LOCATION OF WELL: Owner's No. \_\_\_\_\_

CITY AND STATE: Corvallis, Oregon

NE 1/4 SW 1/4 Sec. 23 T. 11 N. S. R. 5 E. W., W.M.

Bearing and distance from section or subdivision  
corner 20.1 chains E. 37.5 S. of NW cor. of claim #47.

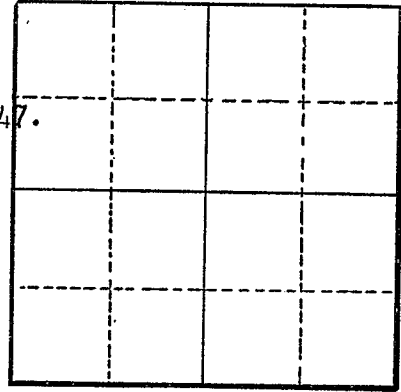

Section \_\_\_\_\_

Altitude at well \_\_\_\_\_

TYPE OF WELL: drilled Date Constructed 1952

Depth drilled 146 Depth cased 267

### CASING RECORD:

6-inch

### FINISH:

### AQUIFERS:

Sandstone and rock

### WATER LEVEL:

246-feet

PUMPING EQUIPMENT: Type Fairbanks Morse Submersible H.P. 1  
Capacity 20 G.P.M.

### WELL TESTS:

Drawdown \_\_\_\_\_ ft. after \_\_\_\_\_ hours Pumping 15 G.P.M.  
Drawdown \_\_\_\_\_ ft. after \_\_\_\_\_ hours \_\_\_\_\_ G.P.M.

USE OF WATER irrigation Temp. \_\_\_\_\_ °F. \_\_\_\_\_, 19\_\_\_\_

SOURCE OF INFORMATION GR-2080

DRILLER or DIGGER \_\_\_\_\_

### ADDITIONAL DATA:

Log X Water Level Measurements \_\_\_\_\_ Chemical Analysis \_\_\_\_\_ Aquifer Test \_\_\_\_\_

### REMARKS:

Sandstone 28  
Blue rock 44  
first water 70 130  
Sand rock lots of water 4 146  
Water raised to within 54' of G.