

STATE ENGINEER  
Salem, Oregon

# Well Record

*Benton* STATE WELL NO. 11/5W-24J  
COUNTY Benton  
*3917* APPLICATION NO. GR-2621

OWNER: Ira J. Shaffer

MAILING

ADDRESS: Route 1, Box 463

LOCATION OF WELL: Owner's No. \_\_\_\_\_


CITY AND

STATE: Corvallis, Oregon

NE ¼ SE ¼ Sec. 24 T. 11 S., R. 5 W., W.M.

Bearing and distance from section or subdivision  
corner South 27° 18' West 49 chains of the

NE Corner, A. Stewart Claim No. 46

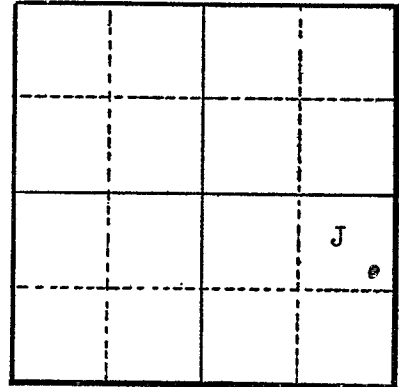

Section 24

Altitude at well 220 feet

TYPE OF WELL: Drilled Date Constructed prior to 1950

Depth drilled 78 feet Depth cased 78 feet

### CASING RECORD:

12 x 1/4" thick casing set from surface to bottom

### FINISH:

### AQUIFERS:

sand and clay

### WATER LEVEL:

38 feet

PUMPING EQUIPMENT: Type Peerless Turbine H.P. \_\_\_\_\_  
Capacity 300 G.P.M.

### WELL TESTS:

Drawdown 4 ft. after \_\_\_\_\_ hours 300 G.P.M.

Drawdown \_\_\_\_\_ ft. after \_\_\_\_\_ hours \_\_\_\_\_ G.P.M.

USE OF WATER Irrigation Temp. \_\_\_\_\_ °F. \_\_\_\_\_, 19\_\_\_\_

SOURCE OF INFORMATION GR-4045

DRILLER or DIGGER \_\_\_\_\_

### ADDITIONAL DATA:

Log  Water Level Measurements \_\_\_\_\_ Chemical Analysis \_\_\_\_\_ Aquifer Test \_\_\_\_\_

### REMARKS:

silt loam and clay non-water bearing	38	38
sand and gravel water bearing	20	58
yellow hard clay	10	68
black sand water bearing	2	70
wood material	1½	71½
black sand and gravel water bearing	71½	78